


STATE OF KANSAS
STATE CORPORATION COMMISSION

WELL PLUGGING RECORD

Give All Information Completely
Make Required Affidavit
Mail or Deliver Report to:
Conservation Division
State Corporation Commission
800 Bitting Building
Wichita, Kansas

McPherson County, Sec. 26 Twp. 21 Rge. (E) 3 (W)

Location as "NE/CNW/SW" or footage from lines SW/4 SE/4 SE/4
Lease Owner Harper Well Service
Lease Name Juhnke Well No. 1
Office Address 414 East Marlin, McPherson, Kansas
Character of Well (completed as Oil, Gas or Dry Hole) Dry Hole
Date well completed May 5, 1956
Application for plugging filed 19
Application for plugging approved 19
Plugging commenced May 5, 1956
Plugging completed May 5, 1956
Reason for abandonment of well or producing formation Dry Hole

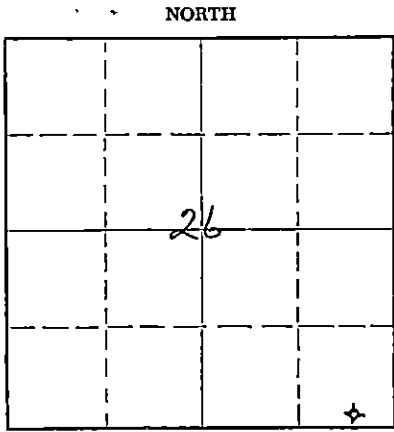

Locate well correctly on above Section Plat

If a producing well is abandoned, date of last production 19
Was permission obtained from the Conservation Division or its agents before plugging was commenced? Yes (Verbal)

Name of Conservation Agent who supervised plugging of this well Ruel Durkee
Producing formation Depth to top Bottom Total Depth of Well 3560 Feet
Show depth and thickness of all water, oil and gas formations.

OIL, GAS OR WATER RECORDS

CASING RECORD

FORMATION	CONTENT	FROM	TO	SIZE	PUT IN	PULLED OUT
Dry Hole				8-5/8"	262'	None

Describe in detail the manner in which the well was plugged, indicating where the mud fluid was placed and the method or methods used in introducing it into the hole. If cement or other plugs were used, state the character of same and depth placed, from feet to feet for each plug set.

Heavy Mud	From 3560' to 270'	Wood Plug at 270'
15 sacks cement	From 270' to 221'	
Heavy Mud	From 221' to 20'	Wood Plug at 20'
5 sacks cement	From 20' to 6'	
Surface Soil	From 6' to 0'	

6-29-56

(If additional description is necessary, use BACK of this sheet)
Name of Plugging Contractor J. A. Melland, Rotary Drilling Contractor
Address 1111 North Main Street, Hutchinson, Kansas

STATE OF Kansas, COUNTY OF McPherson, ss.
(employee of owner) or (owner or operator) of the above-described well, being first duly sworn on oath, says: That I have knowledge of the facts, statements, and matters herein contained and the log of the above-described well as filed and that the same are true and correct. So help me God.

(Signature) *J. A. Melland*
1111 N. Main, Hutchinson (Address)

SUBSCRIBED AND SWORN to before me this 25 day of June, 1956
Ruel Durkee
Notary Public.

My commission expires Oct. 31, 1959
24-7388-5 3-53-20M

ROBERT W. HUBER
NOTARY PUBLIC
MY COMMISSION EXPIRES OCT. 31, 1959

PLUGGING
FILE SEC. 26 T. 21 R. 3W
BOOK PAGE 61 LINE 18

W E L L R E C O R DLEASE NAME Juhnke WELL NO. 1LOCATION SW/4 SE/4 SE/4 Section 26-21S-3W, McPherson County, KansasLEASE OWNER Harper Well Service ✓WORK COMMENCED April 23, 1956 DRILLING COMMENCED April 23, 1956DRILLING COMPLETED May 5, 1956 ELEVATION _____ROTARY DRILLING FROM 0' TO 3560'DRILLING CONTRACTOR J. A. Melland, 1111 N. Main St., Hutchinson, Kansas

FORMATION	FROM	TO	REMARKS
Surface soil & clay	0	35	
Sand	35	80	
Red Bed, shells & shale	80	262	Set and cemented 8-5/8" OD casing at 262' with 175 sacks of cement. Cement circulated.
Shale & lime	262	785	
Lime, sand & shale	785	1235	
Shale & shells	1235	1725	
Lime	1725	1795	
Sandy shale & lime	1795	1850	
Lime	1850	2170	
Lime & shale	2170	2585	
Lime	2585	2835	
Lime & shale	2835	3138	
Lime & chert	3138	3203	
Lime	3203	3225	
Chat & lime	3225	3258	
Sand	3258	3272	
Lime	3272	3457	
Shale	3457	3500	
Shale & lime	3500	3535	
Lime	3535	3560	As no oil or gas in commercial quantities was encountered, authority was granted to plug and abandon the well as follows: Heavy mud from 3560' to 270' - Set wood plug at 270' - 15 sacks of cement from 270' to 221' - Heavy Mud from 221' to 20' - Set wood plug at 20' - 5 sacks of cement from 20' to 6' - Surface soil from 6' to 0' - Plugged and abandoned May 5, 1956.

RECORDED
STATE CORP. COMMISSION

JUL 12 1956

CONSERVATION DIVISION
Wichita, Kansas

PLUGGING

FILE SEC. 26 T. 21 R. 3W
BOOK PAGE 61 LINE 18