


WELL PLUGGING RECORD

Give All Information Completely
Make Required Affidavit
Mail or Deliver Report to:
Conservation Division
State Corporation Commission
212 No. Market
Wichita, Kansas

NORTH

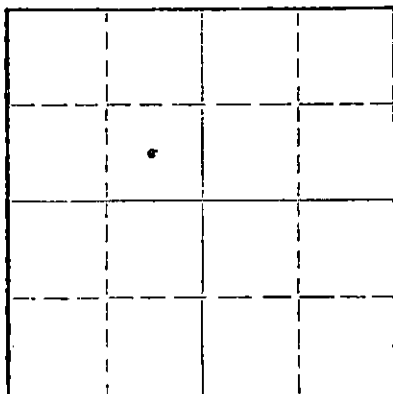

Locate well correctly on above
Section Plat

Rice County, Sec. 25 Twp. 21S Rge. (E) 8 (W)

Location as "NE/CNW/SW" or footage from lines C SE NW

Lease Owner H. L. Herbel

Lease Name L. J. Driver Well No. 3

Office Address P.O. Box 327, Chase, Kansas

Character of Well (completed as Oil, Gas or Dry Hole) dry hole

Date well completed 19

Application for plugging filed September 4 19 68

Application for plugging approved 19

Plugging commenced November 22 19 68

Plugging completed November 26 19 68

Reason for abandonment of well or producing formation dry hole

If a producing well is abandoned, date of last production 19

Was permission obtained from the Conservation Division or its agents before plugging was commenced? yes

Name of Conservation Agent who supervised plugging of this well Gilbert Toman

Producing formation Depth to top Bottom Total Depth of Well 3475 Feet

Show depth and thickness of all water, oil and gas formations.

OIL, GAS OR WATER RECORDS

CASING RECORD

FORMATION	CONTENT	FROM	TO	SIZE	PUT IN	PULLED OUT
		0	271'	8 5/8"	271'	none
		0	3474'	4 1/2"	3474'	2926.64

Describe in detail the manner in which the well was plugged, indicating where the mud fluid was placed and the method or methods used in introducing it into the hole. If cement or other plugs were used, state the character of same and depth placed, from feet to feet for each plug set.

Pushed plug to 3375', set 10' sand bridge and dumped 3 sacks of cement.

Pushed plug to 260', set 10' rock bridge and dumped 25 sacks of cement.

Filled hole with mud to 40' and capped hole with 10 sacks of cement.

RECEIVED
STATE CORPORATION COMMISSION
DEC 4 1968
CONSERVATION DIVISION
Wichita, Kansas

(If additional description is necessary, use BACK of this sheet)

Name of Plugging Contractor Pipe Pullers, Inc.
Address Box 486, Ellinwood, Kansas

STATE OF Kansas, COUNTY OF Barton, ss.
Evelyn Roth (employee of owner) or (owner or operator) of the above-described well, being first duly sworn on oath, says: That I have knowledge of the facts, statements, and matters herein contained and the log of the above-described well as filed and that the same are true and correct. So help me God.

(Signature) Evelyn Roth
Ellinwood, Kansas

SUBSCRIBED AND SWORN TO before me this 2nd day of December 19 68

My commission expires Feb. 10, 1971

(Address)
George A Meyer
Notary Public.

THE PURE OIL COMPANY
WELL LOG AND RELATED DATA

DIVISION Northern Producing DISTRICT Central (Buffalo-Kan.) LEASE Driver, L. J.
 ACRES 160 LEASE NO. 29468 AFE NO. 4470 ELEVATION Grd. 1627', D.F. 1629' WELL NO. 3
 400-SEC. 25 TWP. 21S RGE. 8W PRCT.-DIST.-TWP. (Bell Prospect-Sull Creek Miss. Pool.)
 SURVEY _____ COUNTY Rice STATE Kansas

LOG			
FROM	TO	TOTAL	FORMATION
0	3383	3383	Sand. Lm. & shale
3383	BASAL PENN. CONG.		(E.L. Top)
3383	3390	7	Chert & shale
3390	MISS. CHAT		(E.L. Top)
3390	3426	36	Chert & shale
3426	KINDERHOOK		(E.L. Top)
3426	3475	49	Shale
3475			<u>TOTAL DEPTH</u>
	PLUGGED BACK		
3475	3405	70	Cmt. in 4 1/2" casg.
3405			<u>TOTAL DEPTH PB</u>

(All measurements taken from top of rotary bushing which is 3' above derrick floor.)

RECEIVED
STATE CORPORATION COMMISSION
SEP 5 1968
CONSERVATION DIVISION
Wichita, Kansas

LOCATION			
3300	FEET NORTH OF SOUTH SECTION LINE		
1980	FEET EAST OF WEST SECTION LINE		
1980	FEET SOUTH OF NORTH SECTION LINE		
3300	FEET WEST OF EAST SECTION LINE		

SCALE 2"=1 MILE

CASING AND CEMENTING RECORD			
SIZE CASING	8-5/8"	4-1/2"	
THREAD	8 rd	8 rd	
WEIGHT	24#	11.6 @ 9.5#	
GRADE	J-55	J-55	
CONDITION	A	A	
SET AT	271'	317 1/2'	
SACKS CEMENT	275	130	
SIZE OF HOLE	12-1/4	7-7/8	

Temp. survey 6/8/61 indicated top of cement behind 4 1/2" casg. @ 2950'.

LINER RECORD						
SIZE	WT.	COND.	LENGTH	BLANK	PERF.	SET AT

GUN PERFORATING RECORD					
DATE	CASING	FROM	TO	SIZE SHOTS	NO. SHOTS
6-10-61	4-1/2"	3390	3422	Jet	64
6-11-61	4-1/2"	3379	3380	Jet	4

(Additional perforations reverse side)

SHOT OR ACID RECORD				
DATE	TOP	BOTTOM	SHOT-ACID	REMARKS

(See reverse side for treatments.)

DRILLING: COMMENCED 5-30-61 COMPLETED 6-6-61
 ELECTRICAL SURVEY BY Schlumberger (1) DATE 6-6-61
 DRILLED WITH (Gabbert & Jones) (Rotary) TOOLS
 DRILLED IN WITH (Gabbert & Jones) Rotary TOOLS
 FIRST PROD.—NAT. DATE Dry Hole HRS. _____ BBLs. _____ OIL
 WATER _____ M CU. FT. GAS _____ LBS. ROCK PRESS.
 FIRST PROD. AFTER ACID—DATE Dry Hole HRS. _____ BBLs. _____ OIL
 WATER _____ M CU. FT. GAS _____ LBS. ROCK PRESS.
 GAS/OIL RATIO _____ POTENTIAL Dry Hole BBLs.
 GRAVITY _____ TEMP. _____ GRADE _____

Sonic & Laterologs (3470)

DATE ABANDONED—SOLD _____