

15-009-16134-0070

STATE OF KANSAS  
STATE CORPORATION COMMISSION

Form CP-4


WELL PLUGGING RECORD

Give All Information Completely  
Make Required Affidavit  
Mail or Deliver Report to:  
Conservation Division  
State Corporation Commission  
211 No. Broadway  
Wichita, Kansas

BARTON County. Sec. 8 Twp. 16S Rge. 13W (E) (W)

Location as "NE/CNW/SE/SW" or footage from lines. NE SE NE  
Lease Owner HERNDON DRILLING CO  
Lease Name BITTER "B" Well No. 1  
Office Address BOX 489, TULSA, OKLAHOMA  
Character of Well (completed as Oil, Gas or Dry Hole) OIL  
Date well completed 19  
Application for plugging filed DECEMBER 16 19 65  
Application for plugging approved 19  
Plugging commenced DECEMBER 27 19 65  
Plugging completed DECEMBER 30 19 65  
Reason for abandonment of well or producing formation DEPLETED

NORTH

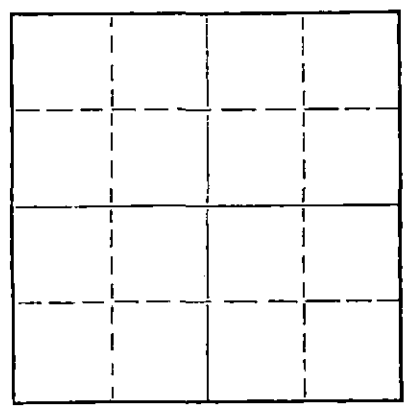

Locate well correctly on above  
Section Plat

If a producing well is abandoned, date of last production 19  
Was permission obtained from the Conservation Division or its agents before plugging was commenced? YES

Name of Conservation Agent who supervised plugging of this well DON TRUAN  
Producing formation Depth to top Bottom Total Depth of Well 3405 Feet  
Show depth and thickness of all water, oil and gas formations.

OIL, GAS OR WATER RECORDS

CASING RECORD

FORMATION	CONTENT	FROM	TO	SIZE	PUT IN	PULLED OUT
				8 5/8"	369	NONE
				5 1/2"	3404'	137'

Describe in detail the manner in which the well was plugged, indicating where the mud fluid was placed and the method or methods used in introducing it into the hole. If cement or other plugs were used, state the character of same and depth placed, from feet to feet for each plug set.

3404' - 3290' - PLUG  
3290' - 3260' - SAND  
3260' - 3218' - 5 SACKS CEMENT  
3218' - 360' - MUD  
360' - 350' - ROCK BRIDGE  
350' - 100' - 25 SACKS CEMENT  
100' - 40' - MUD  
40' - 30' - ROCK BRIDGE  
30' - BASE - 10 SACKS CEMENT

RECEIVED  
STATE CORPORATION COMMISSION  
JAN 4 1966  
CONSERVATION DIVISION  
WICHITA, KANSAS

(If additional description is necessary, use BACK of this sheet)  
Name of Plugging Contractor SANTA-FE PIPE & SUPPLY, INC.  
Address BOX 562, GREAT BEND, KANSAS

STATE OF KANSAS COUNTY OF BARTON, ss.  
T.L. NUTT (employee of owner) or (owner or operator) of the above-described

well, being first duly sworn on oath, says: That I have knowledge of the facts, statements, and matters herein contained and the log of the above-described well as filed and that the same are true and correct. So help me God.

(Signature) [Signature]  
BOX 562, GREAT BEND, KANSAS (Address)

SUBSCRIBED AND SWORN to before me this 3rd day of JANUARY 19 66

My commission expires JULY 31, 1966 [Signature] Notary Public.

WELL LOG BUREAU KANSAS GEOLOGICAL SOCIETY  
412 Union National Bk. Bldg., Wichita, Kansas

15-009-16134-0000


COPY

Company - HERNDON DRILLING  
Farm - Bitter "B" No. 1

SEC. 8 T. 16 R. 13W  
NE SE NE

Total Depth. 3405  
Comm. 2-1-46 Comp. 2-14-66  
Shot or Treated.  
Contractor.  
issued 9-14-46

County. Barton  
KANSAS

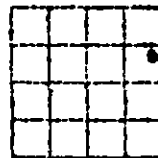

CASING:  
8 5/8" 270' Cem.  
5" 3404' Cem.

Elevation. \_\_\_\_\_

Production. Pot. 93 Bbls.

Figures Indicate Bottom of Formations.

T.R.B. to B. Cellar	914'
shale & shells	215
shale & sand	540
shale & shells	890
Anhydrite	925
shale & shells	1585
shale & lime	1595
lime & shale	2530
shale & shells	2770
shale & lime	2883
lime	3085
shale & shells	3145
lime & shale	3180
lime	3405
Total Depth	

Tops:

Lansing KC Lime	3153
Oolitic limestone with poor porosity & no oil stain.	3179-3185
Oolitic limestone with fair to poor porosity & only a trace of oil stain.	3235-3262
Oolitic limestone with poor porosity & a few pieces oil stained.	3298-3301
Oolitic limestone with very poor porosity & a trace of oil stain.	3312-3317
Arbuckle dolomite	3404
light, med crystalline dolomite with a few pieces porous & oil stained & fair oil odor.	3404-3405

RECEIVED  
STATE CORPORATION COMMISSION  
JAN 4 1966  
CONSERVATION DIVISION  
Wichita, Kansas

RECEIVED  
DEC 24 1965  
Santa Fe Pipe & Supply