

This form shall be filed in duplicate with the Kansas Corporation Commission, 200 Colorado Derby Building, Wichita, Kansas 67202, within ten days after the completion of the well, regardless of how the well was completed.

X Attach separate letter of request if the information is to be held confidential. If confidential, only file one copy. Information on side one will be of public record and side two will then be held confidential.

Circle one: Oil, Gas, Dry, SWD, OWWO, Injection. Type and complete ALL sections. Applications must be filed for dual completion, commingling, SWD and injection.

Attach wireline logs (i.e. electrical log, sonic log, gamma ray neutron log, etc.). KCC # (316) 263-3238. (Rules 82-2-105 & 82-2-125)

OPERATOR Cinco Exploration Co.
c/o Melvin Klotzman
ADDRESS P.O. Box 3723
Victoria, TX 77903

API NO. 15-097-20,836-00-00
COUNTY Kiowa

**CONTACT PERSON Melvin Klotzman
PHONE 1-800-531-3640

FIELD Wildcat *URSULA NW*
PROD. FORMATION Mississippian Chert

PURCHASER Not designated
ADDRESS _____

LEASE Vieux
WELL NO. 1

DRILLING CONTRACTOR H-30, INC
ADDRESS 251 N. Water, Suite 10
Wichita, KS 67202

WELL LOCATION SE SW SE
330 Ft. from S Line and
1650 Ft. from E Line of
C SE
the SW SESEC. 30 TWP. 28S RGE. 18W

PLUGGING CONTRACTOR _____
ADDRESS _____

STATE CORPORATION COMMISSION

RECEIVED
FEB 10 1982 2-10-82


CONSERVATION DIVISION
Wichita, Kansas

TOTAL DEPTH 5160' PBD 4940

SPUD DATE 11/16/81 DATE COMPLETED 11/28/81

ELEV: GR 2279' DF _____ KB 2291'

DRILLED WITH ~~XXXXXX~~ (ROTARY) ~~XXXXX~~ TOOLS

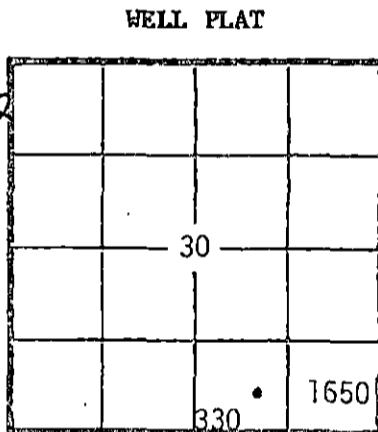

KCC
KGS
(Office Use)

Amount of surface pipe set and cemented 10 joints 8-5/8". DV Tool Used? N/A
set at 432'

AFFIDAVIT

STATE OF Texas, COUNTY OF Victoria SS, I, _____

Melvin Klotzman OF LAWFUL AGE, BEING FIRST DULY SWORN UPON HIS OATH,

DEPOSES THAT HE IS Petroleum Consultant (FOR)(OF) CINCO EXPLORATION COMPANY

OPERATOR OF THE Vieux LEASE, AND IS DULY AUTHORIZED TO MAKE

THIS AFFIDAVIT FOR AND ON THE BEHALF OF SAID OPERATOR, THAT WELL NO. 1 ON

SAID LEASE HAS BEEN COMPLETED AS OF THE 16th DAY OF January, 19 82, AND THAT

ALL INFORMATION ENTERED HEREIN WITH RESPECT TO SAID WELL IS TRUE AND CORRECT.

FURTHER AFFIANT SAITH NOT.

(S) Melvin Klotzman

SUBSCRIBED AND SWORN BEFORE ME THIS 8th DAY OF February, 19 82.

Betty Jean Davis
NOTARY PUBLIC

MY COMMISSION EXPIRES: 2-06-85

**The person who can be reached by phone regarding any questions concerning this information. Within 45 days of completion, a witnessed initial test by the Commission is required if the well produces more than 25 BOPD or is located in a Basic Order Pool.

P.O. Box 3723
Victoria, Texas 77903
Office: 512-573-2416 (24 Hours)
Residence: 512-575-5053

Out of State WATS
800-531-3640
Houston Phone
713-228-4058
Texas WATS
800-242-0085

MELVIN KLOTZMAN
PETROLEUM CONSULTANT, INC.
REGISTERED ENGINEER

February 15, 1984

Kansas Corporation Commission
200 Colorado Derby Building
Wichita, Kansas 67202

RE: CINCO ENERGY COMPANY
Operator No.: 8819
Kansas Producing Wells

Gentlemen:

Effective March 1, 1984 the wells listed below by company in Kansas will have an operator name change. These wells as of the effective date above will be operated by CINCO ENERGY COMPANY, 3935 Hartsdale, Houston, Texas 77063, the field office is Melvin Klotzman, Petroleum Consultant, Inc., P. O. Box 3723, Victoria, Texas 77903.

CINCO EXPLORATION COMPANY

<u>WELL NAME & NO.</u>	<u>API NUMBER</u>	<u>COUNTY</u>	<u>LOCATION</u>	<u>SECTION</u>
Endicott #A-1	15-095-21,251	Kingman County, KS	C NW SE	23-27-6W
Dunbar #3	15-093-20,899	Kiowa County, KS	NE NE NE	1-29-16W
Dunbar #5	15-097-20,922	Kiowa County, KS	C SW NE	1-29-16W
Machesney #1-A	15-097-20,554	Kiowa County, KS	SE SE	36-28-1
Machesney #2	15-097-20,984	Kiowa County, KS	SE SE	36-28-16W
Pyle #A-1	15-097-20,915	Kiowa County, KS	NE	34-27-19W
Pyle #B-1	15-097-20,924	Kiowa County, KS	NE NE NE	3-2S-17W
Vieux #1	15-097-20,836	Kiowa County, KS	SE SW SE	30-28S-18W
Miller "B" #1	15-097-20,920	Kiowa County, KS	C SE SW	3-28S-19W
Doggett #2	15-047-20,761	Edwards County, KS	C SW SE SE	24-26-16W
Parkin #1	15-097-20,935	Kiowa County, KS	C NW/4 SE/4	26-29-18W
Lubbers #1	15-155-20,741	Reno County, KS	C NW SW	16-26-8W
Brooks #1	15-155-20,776	Reno County, KS	C NE SW	17-26S-8W
Zigler #1	15-179-20,656	Sheridan County, KS	SE SW	17-10-28
Hartman #1	15-063-20,653	Gove County, KS	C NW W	5-11S-28W

RECEIVED
STATE CORPORATION COMMISSION

FEB 21 1984

CONSERVATION DIVISION
Wichita, Kansas

Kansas Corporation Commission
RE: Cinco Energy Company
Operator Name Change
February 16, 1984
Page - 2 -

HOUSTON HYDROLANCE INTERNATIONAL, INC.

<u>WELL NAME & NO.</u>	<u>API NUMBER</u>	<u>COUNTY</u>	<u>LOCATION</u>	<u>SECTION</u>
Horinek #1	15-153-20,983	Rawlins County, KS	NW NW SW	3-1S-33W
Horinek #2	15-153-20,509	Rawlins County, KS	SW NW SW	3-1-33W
Aloise #1	15-153-20,510	Rawlins County, KS	SE NE SE	3-1-33W
Frickey #1	15-039-20,692	Decatur County, KS	C NE SW	29-2-28W
Ufford #1	15-039-20,694	Decatur County, KS	C NE SE	10-3S-29W
A & W Farms #1	15-151-21,291	Pratt County, KS	NE NW	8-28-15W
Macfee #1	15-039-20,688	Decatur County, KS	NE SE	3-2-27W
Macfee #2	15-039-20,695	Decatur County, KS	SE NW SE	3-25-27W

If there is any further information or forms required to complete this please call.

Yours very truly,



Melvin Klotzman
Petroleum Consultant for
CINCO ENERGY COMPANY

MK/kk

cc: Cinco Energy Company - Houston & Amarillo, Texas