


STATE OF KANSAS
STATE CORPORATION COMMISSION

Give All Information Completely
Make Required Affidavit
Mail or Deliver Report to:
Conservation Division
State Corporation Commission
211 No. Broadway
Wichita, Kansas

WELL PLUGGING RECORD

Handwritten mark

NORTH

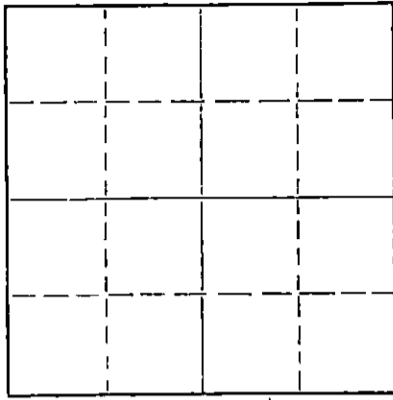

Locate well correctly on above
Section Plat

Mc Pherson County. Sec. 20 Twp. 21 Rge. 1 (E) W (W)
Location as "NE/CNW/SW" or footage from lines SE SW NE 20-21-1W
Lease Owner Jenkins-Ray Supply
Lease Name Chavez Well No. #2
Office Address Box 967, Ponca City, Oklahoma
Character of Well (completed as Oil, Gas or Dry Hole) _____
Date well completed _____ 19____
Application for plugging filed _____ 19____
Application for plugging approved _____ 19____
Plugging commenced 2-21-62 _____ 19____
Plugging completed 2-26-62 _____ 19____
Reason for abandonment of well or producing formation Depleted

If a producing well is abandoned, date of last production _____ 19____
Was permission obtained from the Conservation Division or its agents before plugging was commenced? Yes

Name of Conservation Agent who supervised plugging of this well Cecil Jones
Producing formation _____ Depth to top _____ Bottom _____ Total Depth of Well 3334 Feet
Show depth and thickness of all water, oil and gas formations.

OIL, GAS OR WATER RECORDS

CASING RECORD

FORMATION	CONTENT	FROM	TO	SIZE	PUT IN	PULLED OUT
				10 3/4"	142'	None
				7"	3322'	2230'

Describe in detail the manner in which the well was plugged, indicating where the mud fluid was placed and the method or methods used in introducing it into the hole. If cement or other plugs were used, state the character of same and depth placed, from _____ feet to _____ feet for each plug set.

Checked hole to 3334 ' filled hole with gravel to 3310' dumped 6 sacks of cement with dump bailer. Set bridge at 160' and filled hole with 3 1/2 yards of ready mix cement and sand. Filled with rock from 160' to 150'

PLUGGING COMPLETE

RECEIVED
STATE CORPORATION COMMISSION
MAR 22 1962
CONSERVATION DIVISION
Wichita, Kansas

3-22-62

(If additional description is necessary, use BACK of this sheet)

Name of Plugging Contractor Albert Leach
Address Sterling, Colorado

STATE OF Oklahoma, COUNTY OF Kay, ss.

G.T. Ray

XXXXXXXXXX

(employee of owner) or (owner or operator) of the above-described well, being first duly sworn on oath, says: That I have knowledge of the facts, statements, and matters herein contained and the log of the above-described well as filed and that the same are true and correct. So help me God.

(Signature) _____

Ponca City, Oklahoma

(Address)

SUBSCRIBED AND SWORN TO before me this 20th day of March, 19 62

Muomi Baker

Notary Public.

My commission expires 8-3-63

