




STATE OF KANSAS
STATE CORPORATION COMMISSION

Give All Information Completely
Make Required Affidavit
Mail or Deliver Report to:
Conservation Division
State Corporation Commission
211 No. Broadway
Wichita, Kansas

WELL PLUGGING RECORD

NORTH

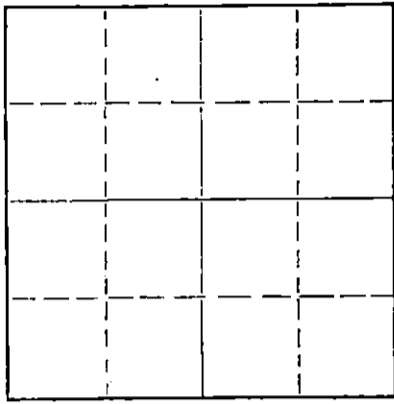

Locate well correctly on above
Section Plat

Mc Pherson County. Sec. 20 Twp. 21 Rge. 1 (E) W (W)
Location as "NE/CNW&SW&" or footage from lines. Gen. Line of NE 20-21-1W
Lease Owner Jenkins-Ray Supply
Lease Name Chavez # 4 Well No. # 4
Office Address Box 967 Ponca City, Oklahoma
Character of Well (completed as Oil, Gas or Dry Hole) _____
Date well completed _____ 19____
Application for plugging filed _____ 19____
Application for plugging approved _____ 19____
Plugging commenced 3-10-62 _____ 19____
Plugging completed 3-16-62 _____ 19____
Reason for abandonment of well or producing formation Depleted

If a producing well is abandoned, date of last production _____ 19____
Was permission obtained from the Conservation Division or its agents before plugging was commenced? Yes

Name of Conservation Agent who supervised plugging of this well Cecil Jones
Producing formation _____ Depth to top _____ Bottom _____ Total Depth of Well 3337 Feet
Show depth and thickness of all water, oil and gas formations.

OIL, GAS OR WATER RECORDS

CASING RECORD

FORMATION	CONTENT	FROM	TO	SIZE	PUT IN	PULLED OUT
				10 3/4"	146'	None
				6"	3331'	2200'

Describe in detail the manner in which the well was plugged, indicating where the mud fluid was placed and the method or methods used in introducing it into the hole. If cement or other plugs were used, state the character of same and depth placed, from _____ feet to _____ feet for each plug set.

Checked hole to 3337' filled hole with gravel to 3320'
Dumped 6 sacks cement with bailer, set bridge at 160' with
10' rocks, filled hole with 3 1/2 yards of cement and sand

PLUGGING COMPLETE

RECEIVED
STATE CORPORATION COMMISSION

MAR 22 1962

CONSERVATION DIVISION
Wichita, Kansas

3-22-62

(If additional description is necessary, use BACK of this sheet)

Name of Plugging Contractor Albert Leach
Address Sterling, Colorado

STATE OF Oklahoma, COUNTY OF Kay, ss.
G.T. Ray

(employee of owner) or (owner or operator) of the above-described well, being first duly sworn on oath, says: That I have knowledge of the facts, statements, and matters herein contained and the log of the above-described well as filed and that the same are true and correct. So help me God.

(Signature) G.T. Ray

Box 967, Ponca City, Oklahoma
(Address)

SUBSCRIBED AND SWORN to before me this 20th day of March, 19 62

Normi Baker

Notary Public.

My commission expires 8-3-62



W RECORD

R

County; McPherson Sec.20 Twp/21S.Rge.1 W

Company Operating; Continental Oil Company , Ponca City, Oklahoma

Farm Name; O. C. Chavez Well No. 4

Drilling started 1-17-40 Drilling completed; 2-12-40

Located 1320' South and 330' East of N/4 corner of section

Hunton lime 3304' 3338'

CASING RECORD

Size	Wt.	Thd.	Make	Amount set	Set at	Cement used
10-3/4"	40#	8	Lap.	146'5"	153'	150 sacks
6"OD	15#	8rd.	Smls.	3330'8"	3305'	300 sacks

FORMATION RECORD

Sandy Clay	0	70
Shale & shells	70	143
Shale	143	148
Sand	148	151
Lime shell	151	153
Shale & shells	153	515
Shale & lime	515	580
Shale & shells	580	668
Shale & lime shells	668	855
Shale & shells	855	1065
Shale	1065	1305
Shale & shells	1305	1732
Broken lime	1732	1825
Shale & shells	1825	1980
Lime	1980	2120
Shale	2120	2220
Broken lime	2220	2300
Lime	2300	2654
Broken lime	2654	2673
Lime	2673	2710
Shale & shells	2710	2835
Shale	2835	2934
Chat	2934	3000
Chert	3000	3035
Chat	3035	3070
Lime	3070	3220
Shale	3220	3258
Shale & shells	3258	3304
Lime	3304	3338
Shale	3338	3345

Perf. 2435-60

Plugged back with cement 3345 3335 TD.

TD. from ground level 3333'6"

RECEIVED
 STATE CONSERVATION COMMISSION
 FEB 23 1962
 CONSERVATION DIVISION
 Wichita, Kansas