

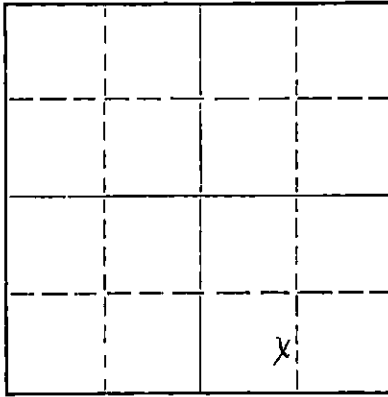
STATE OF KANSAS
STATE CORPORATION COMMISSION

Form CP-4

Give All Information Completely
Make Required Affidavit
Mail or Deliver Report to:
Conservation Division
State Corporation Commission
211 No. Broadway
Wichita, Kansas

WELL PLUGGING RECORD

NORTH

Locate well correctly on above
Section Plat

McPherson County, Sec. 20 Twp. 21 Rge. 1 (E) (W)
 Location as "NE/CNW/SE" or footage from lines. 990' F.S.L. - 1660' F.S.L.
 Lease Owner Floyd King
 Lease Name Hetzke Well No. A-2
 Office Address Lyons, Kansas
 Character of Well (completed as Oil, Gas or Dry Hole) oil well
 Date well completed 19____
 Application for plugging filed 4-8-65 19____
 Application for plugging approved 19____
 Plugging commenced 5-3-65 19____
 Plugging completed 5-4-65 19____
 Reason for abandonment of well or producing formation depleted

If a producing well is abandoned, date of last production 19____
 Was permission obtained from the Conservation Division or its agents before plugging was commenced? yes

Name of Conservation Agent who supervised plugging of this well Gilbert Toman
 Producing formation _____ Depth to top _____ Bottom _____ Total Depth of Well 3327 Feet
 Show depth and thickness of all water, oil and gas formations.

OIL, GAS OR WATER RECORDS

CASING RECORD

FORMATION	CONTENT	FROM	TO	SIZE	PUT IN	PULLED OUT
				13	143	none
				7	3321	1521.45

Describe in detail the manner in which the well was plugged, indicating where the mud fluid was placed and the method or methods used in introducing it into the hole. If cement or other plugs were used, state the character of same and depth placed, from _____ feet to _____ feet for each plug set.

Fill hole with sand to 3315' and dump 5 sacks of cement.
 Set 20' rock bridge from 180' to 160' and dump 5 yards
 ready mix cement.

RECEIVED
STATE CORPORATION COMMISSION

MAY 17 1965

CONSERVATION DIVISION
Wichita, Kansas

5-17-65

(If additional description is necessary, use BACK of this sheet)
 Name of Plugging Contractor Flint Engineering & Construction Company
 Address Box 950, El Dorado, Kansas

STATE OF KANSAS, COUNTY OF BUTLER, ss.

_____, (employee of owner) or (owner or operator) of the above-described well, being first duly sworn on oath, says: That I have knowledge of the facts, statements, and matters herein contained and the log of the above-described well as filed and that the same are true and correct. So help me, God.

(Signature)

El Dorado, Kansas

(Address)

Subscribed and Sworn to before me this 14th day of May, 1965

My commission expires 9-27-67

Notary Public.

WELL RECORD

COUNTY: McPherson. SECTION: 20. TOWNSHIP: 21S. RANGE: 1W
 COMPANY OPERATING: Continental Oil Company. ADDRESS: Box 267, Great Bend, Kansas.
 FARM NAME: F. A. Hetzke "A". WELL NO: No. 2
 DRILLING STARTED: 7-1-36. DRILLING FINISHED: 7-28-36.
 WELL LOCATED: 990' N & 990' East of S/4 Corner.
 CHARACTER OF WELL: Oil Well

Formation Record

<u>Formation</u>	<u>Top</u>	<u>Bottom</u>	<u>Remarks</u>
Surface Clay	15		
Sand	15	45	
Shale & Shells	45	144	
Lime	144	155	Set 143' 1" of 13" OD casing at 149' and and cemented w/150 sacks Incor cement.
Shale & Shells	155	275	
Broken Lime	275	470	
Shale & Shells	470	517	
Broken Lime & Shells	517	687	
Shale & Shells	687	1567	
Broken Lime	1567	1878	
Lime	1878	2108	
Shale & Broken Lime	2108	2244	
Lime	2244	2363	
Broken Lime	2363	2440	
Lime	2440	2753	
Broken Lime	2753	2789	
Shale & Shells	2789	2835	
Lime	2835	2850	
Shale & Shells	2850	2905	
Chat	2905	3076	
Chat (Hard)	3076	3088	
Chat (Blue)	3088	3107	
Chat	3107	3119	
Lime	3119	3190	
Shale & Lime	3190	3207	
Broken Lime	3207	3250	
Shale	3250	3298	
Lime (Hunton)	3298	3326	Set 3321' 3" of 7" OD casing at 3298' and cemented w/300 sacks Atlas and 100 sacks Incor cement. First oil at 3305'. From 3310' to 3315' hole filled up 300' with oil. From 3315-19' hole filled up 1500' w/oil. From 3319-24' hole filled up to 2200'. From 3324-26' hole filled up to 2400'.

RECEIVED
 STATE CORPORATION COMMISSION
 MAY 26 1965
 CONSERVATION DIVISION
 Wichita, Kansas