


Give All Information Completely  
Make Required Affidavit  
Mail or Deliver Report to:  
Conservation Division  
State Corporation Commission  
211 N. Broadway  
Wichita, Kansas

WELL PLUGGING RECORD

McPherson County, Sec. 20 Twp. 21 Rge. 1 (E) (W)

Location as "NE/CNW/SW" or footage from lines 330' F.S.L. - 2310' F.E.L.  
Lease Owner: Floyd King  
Lease Name: Hetzke Well No. A-4  
Office Address: Lyons, Kansas  
Character of Well (completed as Oil, Gas or Dry Hole) oilwell  
Date well completed 19  
Application for plugging filed 4-8-65 19  
Application for plugging approved 5-5-65 19  
Plugging commenced 5-6-65 19  
Plugging completed 19  
Reason for abandonment of well or producing formation depleted

NORTH

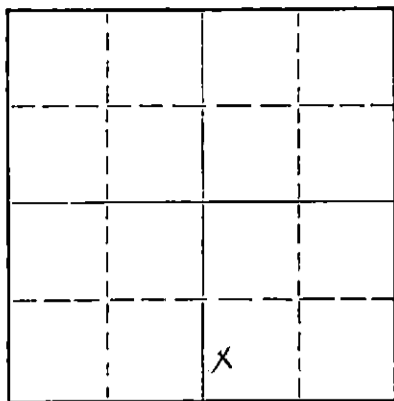

Locate well correctly on above Section Plat

If a producing well is abandoned, date of last production 19  
Was permission obtained from the Conservation Division or its agents before plugging was commenced? yes

Name of Conservation Agent who supervised plugging of this well Gilbert Toman  
Producing formation Depth to top Bottom Total Depth of Well 3319 Feet  
Show depth and thickness of all water, oil and gas formations.

OIL, GAS OR WATER RECORDS

CASING RECORD

FORMATION	CONTENT	FROM	TO	SIZE	PUT IN	PULLED OUT
				10 3/4	136	none
				7	3308	1015.07

Describe in detail the manner in which the well was plugged, indicating where the mud fluid was placed and the method or methods used in introducing it into the hole. If cement or other plugs were used, state the character of same and depth placed, from feet to feet for each plug set.

Well had been plugged back to 3217'  
Fill hole with sand to 3200' and dump 6 sacks of cement.  
Set 20' rock bridge from 200' to 180' and dump 4 yards of ready mix cement

RECEIVED  
STATE CORPORATION COMMISSION

MAY 17 1965  
5-17-65  
CONSERVATION DIVISION  
Wichita, Kansas

(If additional description is necessary, use BACK of this sheet)  
Name of Plugging Contractor Flint Engineering & Construction Company  
Address Box 950, El Dorado, Kansas

STATE OF KANSAS, COUNTY OF BUTLER, ss.

(employee of owner) or (owner or operator) of the above-described well, being first duly sworn on oath, says: That I have knowledge of the facts, statements, and matters herein contained and the log of the above-described well as filed and that the same are true and correct. So help me God.

(Signature) Gaura Bowdle  
El Dorado, Kansas (Address)

SUBSCRIBED AND SWORN TO before me this 14th day of May, 1965

Ronald R. Hanson  
Notary Public.

My commission expires 9-27-67

15.113.04534.0000

WELL RECORDCOUNTY: McPherson. SECTION: 20. TOWNSHIP: 21S. RANGE: 1WCOMPANY OPERATING: Continental Oil Company. ADDRESS: Box 267, Great Bend, KansasFARM NAME: F. A. Hetzke "A". WELL NO: No. 4DRILLING STARTED: 4-13-37. DRILLING FINISHED: 5-10-37.DATE OF FIRST PRODUCTION: 5-17-37.WELL LOCATED: SW/4 SE/4, 330' W, 990' S of Center of Section.CHARACTER OF WELL: Oil Well.Formation Record

<u>Formation</u>	<u>Top</u>	<u>Bottom</u>	<u>Remarks</u>
Clay Sand	0	20	
Shale & Shells	20	65	
Sand	65	85	
Shale & Shells	85	140	
Lime	140	146	Set 136'1" of 10" casing at 141' and
Shale & Shells	146	431	cemented with 165 sacks Victor cement.
Lime	431	484	
Red Rock	484	488	
Broken Lime	488	542	
Shale	542	642	
Shale & Shells	642	730	
Lime	730	801	
Shale & Shells	801	1239	
Shale	1239	1429	
Shale & Shells	1429	1715	
Shale	1715	1765	
Lime	1765	1825	
Broken Lime	1825	1923	
Lime	1923	1993	
Broken Lime	1993	2069	
Lime	2069	2120	
Broken Lime	2120	2134	
Shale	2134	2228	
Lime	2228	2723	
Shale & Shells	2723	2748	
Shale	2748	2870	
Shale & Shells	2870	2912	
Shale	2912	2915	
Chat	2915	3073	
Lime	3073	3160	
Broken Lime	3160	3172	
Lime	3172	3189	
Shale	3189	3285	
Lime - Hunton	3285	3326	Set 3308'6" of 7" OD Casing at 3286' and

cemented with 500 sacks Ash Grove cement.

1,000' oil in hole from 3313-18'.

Hole filled up 1,250' w/oil at 3326'.

RECEIVED  
STATE CORPORATION COMMISSION

MAY 26 1965

CONSERVATION DIVISION  
Wichita, Kansas