


Give All Information Completely  
Make Required Affidavit  
Mail or Deliver Report to:  
Conservation Division  
State Corporation Commission  
211 No. Broadway  
Wichita, Kansas

## WELL PLUGGING RECORD

15.113.04537.0000

NORTH

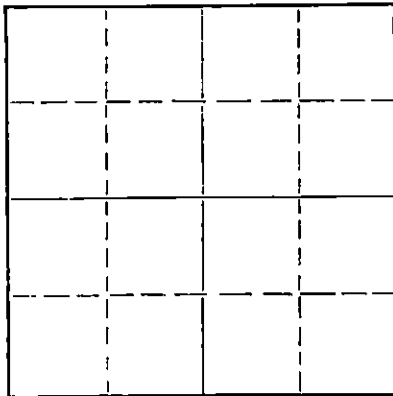

Locate well correctly on above  
Section Plat

McPherson

County. Sec. 20 Twp. 21 Rge. 1 (E) W (W)

Location as "NE/CNW/SW" or footage from lines 330'S, 2310'W  
Lease Owner Jenkins-Ray Supply  
Lease Name Kinderblade Well No. 3  
Office Address Ponca City, Oklahoma  
Character of Well (completed as Oil, Gas or Dry Hole)  
Date well completed 19  
Application for plugging filed 19  
Application for plugging approved 19  
Plugging commenced 3-1-62 19  
Plugging completed 3-5-62 19  
Reason for abandonment of well or producing formation Depleted.

If a producing well is abandoned, date of last production 19  
Was permission obtained from the Conservation Division or its agents before plugging was commenced? yes

Name of Conservation Agent who supervised plugging of this well Cecil Jones  
Producing formation Depth to top Bottom Total Depth of Well 3326' Feet  
Show depth and thickness of all water, oil and gas formations.

## OIL, GAS OR WATER RECORDS

## CASING RECORD

FORMATION	CONTENT	FROM	TO	SIZE	PUT IN	PULLED OUT
				10"	137'	None
				7"	3301'	2267'

Describe in detail the manner in which the well was plugged, indicating where the mud fluid was placed and the method or methods used in introducing it into the hole. If cement or other plugs were used, state the character of same and depth placed, from feet to feet for each plug set.

Checked hole to 3326', sanded to 3290' and dumped 7 sacks of cement @ 3290' with dump bailer. Pulled 7" casing. Set rock bridge from 150' to 135' and filled to base of cellar with 3½ yards of cement.

PLUGGING COMPLETE.

**RECEIVED**  
STATE CORPORATION COMMISSION

MAR 22 1962

CONSERVATION DIVISION  
Wichita, Kansas

3-22-62

Name of Plugging Contractor Knight Casing Pulling Company  
Address Chase, Kansas  
(If additional description is necessary, use BACK of this sheet)

STATE OF Kansas, COUNTY OF Rice, ss.  
Noel J. Knight

(employee of owner) or (owner) of the above-described well, being first duly sworn on oath, says: That I have knowledge of the facts, statements, and matters herein contained and the log of the above-described well as filed and that the same are true and correct. So help me God.

(Signature)

Noel J. Knight

Chase, Kansas

(Address)

SUBSCRIBED AND SWORN TO before me this 14th day of March, 1962

My commission expires May 20, 1964

Milton J. Volin

Notary Public.

