


WELL PLUGGING RECORD

Give All Information Completely
Make Required Affidavit
Mail or Deliver Report to:
Conservation Division
State Corporation Commission
211 No. Broadway
Wichita, Kansas

McPherson County, Sec. 20 Twp. 21 Rge. 1 (E) W (W)

Location as "NE/CNW/SW" or footage from lines 330' N & 330' W. of C
Lease Owner Jenkins-Ray Supply
Lease Name F. D. Meyer Well No. 1
Office Address Ponca City, Oklahoma
Character of Well (completed as Oil, Gas or Dry Hole)
Date well completed 19____
Application for plugging filed 19____
Application for plugging approved 19____
Plugging commenced 2-24-62 19____
Plugging completed 2-27-62 19____
Reason for abandonment of well or producing formation Depleted.

NORTH

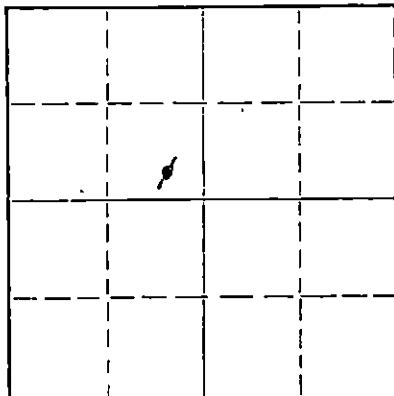

Locate well correctly on above Section Plat

If a producing well is abandoned, date of last production 19____
Was permission obtained from the Conservation Division or its agents before plugging was commenced? YES

Name of Conservation Agent who supervised plugging of this well Cecil Jones
Producing formation _____ Depth to top _____ Bottom _____ Total Depth of Well 3342 Feet
Show depth and thickness of all water, oil and gas formations.

OIL, GAS OR WATER RECORDS

CASING RECORD

FORMATION	CONTENT	FROM	TO	SIZE	PUT IN	PULLED OUT
				10"	139'	None
				7"	3319'	None

Describe in detail the manner in which the well was plugged, indicating where the mud fluid was placed and the method or methods used in introducing it into the hole. If cement or other plugs were used, state the character of same and depth placed, from _____ feet to _____ feet for each plug set.

Checked hole to 3342', sanded to 3315' and ran 7 sacks of cement @ 3315'. Well had been squeezed. Set plug @ 400', set 25' rock bridge and filled hole with ready-mix cement from 375' to base of cellar.

PLUGGING COMPLETE.

RECEIVED
STATE CORPORATION COMMISSION

MAR 22 1962

CONSERVATION DIVISION

3-22-62

Name of Plugging Contractor Knight Casing Pulling Company
Address Chase, Kansas

STATE OF Kansas, COUNTY OF Rice, ss.
Noel J. Knight (employee of owner) or (owner) of the above-described well, being first duly sworn on oath, says: That I have knowledge of the facts, statements, and matters herein contained and the log of the above-described well as filed and that the same are true and correct. So help me God.

(Signature) Noel J. Knight
Chase, Kansas
(Address)

SUBSCRIBED AND SWORN TO before me this 13th day of March, 1962

My commission expires May 20, 1964 Milton J. Volin Notary Public.



Q

WELL RECORD
F. D. MEYER No. 1

Location: 330' N and 330' W of Center of Section 20, T 21 S,
R 1 W, McPherson County, Kansas

DRILLING STARTED: 2-28-38 - 3-28-38

<u>Formation</u>	<u>Top</u>	<u>Bottom</u>	<u>Casing</u>
Surface Clay	0	15	
Sand	15	20	
Shale	20	103	
Shale & Shells	103	145	
Lime	145	151	Set 139'5" of 10" Csg.
Shale & Shells	151	782	@ 147' and cemented w/
Broken Lime	782	894	150 sx Victor Cement
Shale & Shells	894	1234	
Shale	1234	1404	
Shale & Shells	1404	1790	
Lime	1790	1837	
Broken Lime	1837	1980	
Lime	1980	2042	
Broken Lime	2042	2097	
Shale & Shells	2097	2225	
Lime	2225	2259	
Broken Lime	2259	2315	
Lime	2315	2612	
Shale & Shells	2612	2677	
Broken Lime	2677	2732	
Shale & Shells	2732	2821	
Shale	2821	2897	
Shale & Shells	2897	2914	
Chat	2914	3025	
Lime	3025	3195	
Shale	3195	3291	
Hunton Lime	3291	3334	
Lime & Shale Sandy	3334	3342	

RECEIVED
STATE CORPORATION COMMISSION

FEB 23 1962

CONSERVATION DIVISION
Wichita, Kansas

Set 3319'3" of 7" OD
csg. @ 3292' and
cemented w/300 sx Ash
Grove Cement

Show of oil and gas from
3309 - 3314

CASING RECORD

10" Amt. Set 139'5"
7" OD Amt. Set 3319'3"

CEMENTING AND MUDDING RECORD

10" Amt. Set 139'5" - 150 sx w/Halliburton
7" Amt. Set 3319'3" - 300 sx w/Halliburton

PRODUCTION DATA

507 bbls. of Oil in first 24 hrs.

*All repaired at 143'
squeezed with cement*