

WELL PLUGGING RECORD

Give All Information Completely  
Make Required Affidavit  
Mail or Deliver Report to:  
Conservation Division  
State Corporation Commission  
211 No. Broadway  
Wichita, Kansas

Kearny County, Sec. 16 Twp. 21S Rge. 38 ~~38~~ X (W)

Location as "NE/CNW/SW" or footage from lines NE NE

Lease Owner Cleary Petroleum, Inc.

Lease Name Hildebrand Well No. 1

Office Address 310 Kermac Bldg., Oklahoma City, Okla.

Character of Well (completed as Oil, Gas or Dry Hole) Dry Hole

Date well completed 8/15 19 65

Application for plugging filed 8/31 19 65

Application for plugging approved 9/2 19 65


Plugging commenced 9/13 19 65

Plugging completed 9/17 19 65

Reason for abandonment of well or producing formation All zones drilled are thought to be barren of hydrocarbons.

If a producing well is abandoned, date of last production ----- 19 ---

Was permission obtained from the Conservation Division or its agents before plugging was commenced? Yes

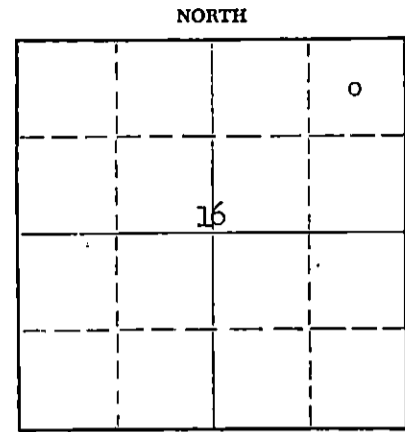

Locate well correctly on above Section Plat

Name of Conservation Agent who supervised plugging of this well Hugh Scott

Producing formation --- Depth to top --- Bottom --- Total Depth of Well 5087 Feet

Show depth and thickness of all water, oil and gas formations.

OIL, GAS OR WATER RECORDS

CASING RECORD

FORMATION	CONTENT	FROM	TO	SIZE	PUT IN	PULLED OUT
All formations drilled	are			8 5/8	306	None
thought to be barren of				5 1/2	5087	3400'
Gas, Oil or water.						

Describe in detail the manner in which the well was plugged, indicating where the mud fluid was placed and the method or methods used in introducing it into the hole. If cement or other plugs were used, state the character of same and depth placed, from --- feet to --- feet for each plug set.

Mix 20 sacks of cement to plug off Perfs. Stop plug at 4800'. Mud to 700' and 25 sacks cement from 700' to 625'. Mud to 325 and pump 25 sacks cement from 325' to 250. Mud to 35' and 10 sacks cement 35' to 3'. Had welder cut 8 5/8 off 3' below ground level and cap/

RECEIVED  
STATE CORPORATION COMMISSION

SEP 30 1965

CONSERVATION DIVISION  
Wichita, Kansas

(If additional description is necessary, use BACK of this sheet)

Name of Plugging Contractor Sargents Casing Pulling Service  
Address Box 506, Liberal, Kansas

STATE OF KANSAS COUNTY OF SEWARD, ss.  
DONALD W. JACKSON (employee of owner) or (owner or operator) of the above-described well, being first duly sworn on oath, says: That I have knowledge of the facts, statements, and matters herein contained and the log of the above-described well as filed and that the same are true and correct. So help me God.

(Signature) Donald W. Jackson

Hill N. Carlton, Liberal, Kansas  
(Address)

SUBSCRIBED AND SWORN TO before me this 29<sup>th</sup> day of September, 1965

My commission expires 12-28-68

Notary Public.

LEASE: HILDEBRAND #1  
 OWNER: CLEARY PETROLEUM, INC.  
 CONT: EARL F. WAKEFIELD  
 COMM: 6-24-65  
 COMP: 7-18-65

LOCATION: NE NE  
 SECTION 16-21S-38W  
 KEARNY COUNTY, KANSAS  
 CASING: 8 5/8" Set @ 302'  
 5 1/2" Set @ 5087'

Surface Soil	20
Sand & Clay	165
Blue Shale	306
Blue Clay & Shells	765
Shale & Sand	875
Red Bed & Shells	1140
Red Bed, Shells & Anhydrite	1630
Shale	1880
Shale, Sand & Anhydrite	1960
Shale & Shells	2144
Shale	2338
Shale & Shells	2741
Shale & Lime	3107
Lime	3512
Lime W/Chalk	3594
Lime	5087
R.T.D.	5087

**RECEIVED**  
 STATE CORPORATION COMMISSION

SEP 30 1965

STATE OF KANSAS )  
 )  
 COUNTY OF SEDGWICK )

SS

CONSERVATION DIVISION  
 Wichita, Kansas

I, FRED S. BARKER, DO HEREBY CERTIFY THAT THE ABOVE IS A TRUE AND CORRECT COPY OF THE DRILLER'S LOG ON THE HILDEBRAND #1, LOCATED IN THE NE NE OF SECTION 16-21S-38W, KEARNY COUNTY, KANSAS.

EARL F. WAKEFIELD

BY

*Fred S. Barker*

SUBSCRIBED AND SWORN TO BEFORE ME THIS 27TH DAY OF JULY, 1965.

MY COMMISSION EXPIRES:  
JANUARY 25, 1969

*Wanda W. Riley*  
 WANDA W. RILEY NOTARY PUBLIC