


STATE OF KANSAS
STATE CORPORATION COMMISSION

WELL PLUGGING RECORD

Give All Information Completely
Make Required Affidavit
Mail or Deliver Report to
Conservation Division
State Corporation Comm.
245 North Water
Wichita, KS 67202

Finney County. Sec. 18 Twp. 21 Rge. 33 E/W
Location as "NE/CNW/SW" or footage from lines
C NE/4

Lease Owner The Maurice L. Brown Company
Lease Name Ella Crist Well No. 1
Office Address 200 Sutton Place, Wichita, Kansas
Character of Well (Completed as Oil, Gas or Dry Hole)
Dry Hole

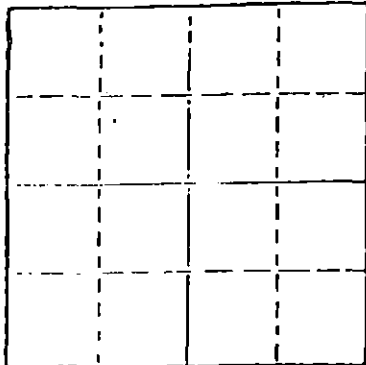

Locate well correctly on above
Section Plat

Date Well completed Sep. 4 1979
Application for plugging filed (verbally) Sep. 4 1979
Application for plugging approved (verbally) Sep. 4 1979
Plugging commenced Sep. 4 1979
Plugging completed Sep. 4 1979
Reason for abandonment of well or producing formation
No commercial quantity of oil or gas encountered
If a producing well is abandoned, date of last production 19

Was permission obtained from the Conservation Division or
its agents before plugging was commenced? Yes

Name of Conservation Agent who supervised plugging of this well Marion Schmidt
Producing formation Depth to top Bottom Total Depth of Well 2790'
Show depth and thickness of all water, oil and gas formations.

OIL, GAS OR WATER RECORDS

CASING RECORD

FORMATION	CONTENT	FROM	TO	SIZE	PUT IN	PULLED OUT

Describe in detail the manner in which the well was plugged, indicating where the mud fluid
was placed and the method or methods used in introducing it into the hold. If cement or other
plugs were used, state the character of same and depth placed, from feet to
feet for each plug set.

T.D. 2790'

Set 1st plug at 820' with 70 sacks
2nd plug at 360' with 20 sacks
3rd plug at 40' solid bridge with 10 sacks
rathole with 5 sacks.

Cemented with 50/50 posmix, 6% gel.
Plug was down at 4:45 p.m., 09-04-79.

RECEIVED
STATE CORPORATION COMMISSION

SEP 17 1979

CONSERVATION DIVISION
Wichita, Kansas

(If additional description is necessary, use BACK of this sheet)

Name of Plugging Contractor Abercrombie Drilling, Inc.

STATE OF Kansas COUNTY OF Sedgwick, ss.
Jack L. Partridge, Asst. Sec.-Treas. (employee of owner) or (owner or operator)
of the above-described well, being first duly sworn on oath, says: That I have knowledge of
the facts, statements, and matters herein contained and the log of the above-described well
as filed and that the same are true and correct. So help me God.

(Signature) Jack L. Partridge
801 Union Center, Wichita, Kansas 67202
(Address)

SUBSCRIBED AND SWORN TO before me this 13th day of September, 1979



Sherrie L. Brooks
Notary Public.

My commission expires 08-21-82

CONTRACTOR'S WELL LOG

OPERATOR: The Maurice L. Brown Company
 CONTRACTOR: Abercrombie Drilling, Inc.
 WELL NAME: Ella Crist #1
 LOCATION: C NE/4, Section 18-21-33
 Finney County, Kansas
 SPUD DATE: August 29, 1979
 COMPLETION DATE: September 04, 1979

0	150	Clay and sand
150	375	Sand and shale
375	1625	Shale
1625	2090	Shale and sand
2090	2368	Shale
2368	2553	Shale and lime
2553	2732	Lime and shale
2732	2790	Shale and lime
	2790	Rotary Total Depth

Spud hole at 5:45 p.m., August 29, 1979. Drilled 375' of 12 1/4" hole. Ran 9 joints of 8-5/8" - 22.36# casing. Set at 371.97' with 150 sacks of Halliburton light, 2% Ca.Cl., 1/4# floccel per sack. Followed with 150 sacks of Class H cement, 3% Ca.Cl., 1/4# floccel per sack. Cement did not circulate. Plug was down at 8:30 a.m., August 30, 1979.

T.D. 2790'. Set 1st plug at 820' with 70 sacks, 2nd plug at 360' with 20 sacks, 3rd plug at 40' solid bridge with 10 sacks, rathole with 5 sacks. Cemented with 50/50 posmix, 6% gel. Plug was down at 4:45 p.m., September 04, 1979.

SAMPLE TOPS:

Anhydrite 2074'
 B/Anhydrite 2090'

RECEIVED
 STATE CORPORATION COMMISSION

SEP 17 1979

CONSERVATION DIVISION
 Wichita, Kansas

STATE OF KANSAS)
) ss
 COUNTY OF SEDGWICK)

Jack L. Partridge, Assistant Secretary-Treasurer of Abercrombie Drilling, Inc., does hereby state that the above and foregoing is a true and correct copy of the log of the Ella Crist #1, C NE/4, Section 18-21-33, Finney County, Kansas.

ABERCROMBIE DRILLING, INC.

BY Jack L. Partridge
 Jack L. Partridge
 Assistant Secretary-Treasurer

Subscribed and sworn to before me, a Notary Public, in and for the county and state aforesaid, as of this 13th day of September, 1979.



Sherrie L. Brooks
 Sherrie Brooks, Notary Public

My commission expires 08-21-82.