


Give All Information Completely
Make Required Affidavit
Mail or Deliver Report to:
Conservation Division
State Corporation Commission
211 No. Broadway
Wichita, Kansas

R

WELL PLUGGING RECORD

NORTH

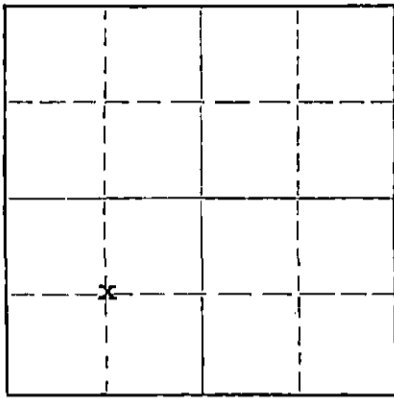

Locate well correctly on above
Section Plat

Finney County, Sec. 25 Twp. 21S Rge. 33W (E) (W)

Location as "NE/CNW/SW" or footage from lines Center of SW/4
Lease Owner Sunray Mid-Continent Oil Company
Lease Name Arles Estes Well No. 1
Office Address 321 West Douglas - Wichita, Kansas
Character of Well (completed as Oil, Gas or Dry Hole) Dry Hole
Date well completed April 19 1961
Application for plugging filed August 9 1961
Application for plugging approved August 11 1961
Plugging commenced August 7 1961
Plugging completed August 8 1961
Reason for abandonment of well or producing formation Dry

If a producing well is abandoned, date of last production _____ 19____
Was permission obtained from the Conservation Division or its agents before plugging was commenced? Yes

Name of Conservation Agent who supervised plugging of this well Frank Broadfoot
Producing formation None Depth to top _____ Bottom _____ Total Depth of Well 2698 Feet
Show depth and thickness of all water, oil and gas formations.

OIL, GAS OR WATER RECORDS

CASING RECORD

FORMATION	CONTENT	FROM	TD	SIZE	PUT IN	PULLED OUT
Hollenberg	Dry	2588	2594	8-5/8"	309'	0
Herrington	water	2626	2632	4-1/2"	2696	1147
Upper Krider	water	2655	TD			

Describe in detail the manner in which the well was plugged, indicating where the mud fluid was placed and the method or methods used in introducing it into the hole. If cement or other plugs were used, state the character of same and depth placed, from _____ feet to _____ feet for each plug set.

Filled hole with gravel from 2698 to 2620". Placed 5 sacks cement from 2620 to 2605'. Filled hole with mud from 2605' to 300' and placed rock bridge at 300'. Twenty sacks cement placed from 300' to 246' and then mud to 35'. Placed rock bridge 35' and filled hole to surface with 10 sacks cement.

RECEIVED
STATE CORPORATION COMMISSION

AUG 18 1961

CONSERVATION DIVISION
Wichita, Kansas

(If additional description is necessary, use BACK of this sheet)
Name of Plugging Contractor Forbes Casing Pulling Company
Address Great Bend, Kansas

STATE OF Kansas, COUNTY OF Sedgwick, ss.
Nash A. Gough (employee of owner) of owner or operator of the above-described well, being first duly sworn on oath, says: That I have knowledge of the facts, statements, and matters herein contained and the log of the above-described well as filed and that the same are true and correct. So help me God.

(Signature)

Nash A. Gough

321 West Douglas - Wichita, Kansas
(Address)

SUBSCRIBED AND SWORN TO before me this 15th day of August, 1961

Notary Public Signature

My commission expires July 13, 1963

Notary Public.



Arlie Estes #1, Section 25-21S-33W, Finney County, Kansas

469 - 570	Shale
570 - 1431	Shale and Sand
1431 - 2050	Red Bed and Shale
2265 - 2479	Shale and Anhydrite
2479 - 2566	Shale and Chalk
2566 - 2675	Lime

RECEIVED
STATE CORPORATION COMMISSION

AUG 18 1961

CONSERVATION DIVISION
Wichita, Kansas