


STATE OF KANSAS
STATE CORPORATION COMMISSION

Form CP-4

WELL PLUGGING RECORD

Give All Information Completely
Make Required Affidavit
Mail or Deliver Report to:
Conservation Division
State Corporation Commission
212 No. Market
Wichita, Kansas

NORTH

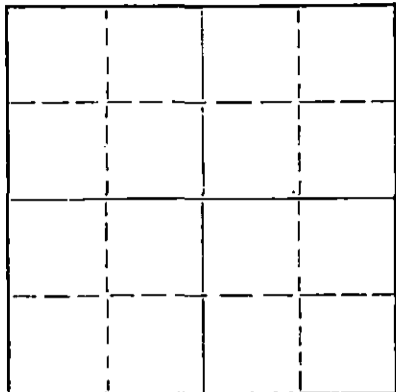

Locate well correctly on above
Section Plat

Kearney County, Sec. 19 Twp. 21S Rge. 35W (E) (W)
Location as "NE/CNW/SW" or footage from lines 1980' SL & EL
Lease Owner Phillips Petroleum Company
Lease Name Arlene Well No. B-#1
Office Address Box 358, Phillips, Texas
Character of Well (completed as Oil, Gas or Dry Hole) Dry Hole
Date well completed 3-12-66 19
Application for plugging filed 3-11-66 19
Application for plugging approved 3-11-66 19
Plugging commenced 3-11-66 19
Plugging completed 3-12-66 19
Reason for abandonment of well or producing formation Dry Hole

If a producing well is abandoned, date of last production 19
Was permission obtained from the Conservation Division or its agents before plugging was commenced? yes

Name of Conservation Agent who supervised plugging of this well Ed Eves, Sublette, Kansas
Producing formation Depth to top Bottom Total Depth of Well 4700 Feet
Show depth and thickness of all water, oil and gas formations.

OIL, GAS OR WATER RECORDS

CASING RECORD

FORMATION	CONTENT	FROM	TO	SIZE	PUT IN	PULLED OUT
				8 5/8"	1260'	none

Describe in detail the manner in which the well was plugged, indicating where the mud fluid was placed and the method or methods used in introducing it into the hole. If cement or other plugs were used, state the character of same and depth placed, from feet to feet for each plug set.

Spotted 35 sacks cement @ 700' thru drill pipe
Set Plug @ 45' with 15 sacks cement

RECEIVED
STATE CORPORATION COMMISSION

MAR 16 1966

CONSERVATION DIVISION
Wichita, Kansas

(If additional description is necessary, use BACK of this sheet)

Name of Plugging Contractor Leben Drilling, Inc.
Address Box 486, Great Bend, Kansas 67530

STATE OF KANSAS, COUNTY OF BARTON, ss.
Leslie Kite (employee of owner) or (owner or operator) of the above-described

well, being first duly sworn on oath, says: That I have knowledge of the facts, statements, and matters herein contained and the log of the above-described well as filed and that the same are true and correct. So help me God.

(Signature) Leslie Kite

P. O. Box 486, Great Bend, Kansas 67530
(Address)

SUBSCRIBED AND SWORN TO before me this 14th day of March, 1966

My commission expires April 1, 1967

Ulanda Nichols
Notary Public.

DRILLER'S LOG

COMPANY: Phillips Petroleum Company
 CONTRACTOR: LEBEN DRILLING, INC.
 FARM: ARLENE B-#1
 LOCATION: 1980' from South Line and East Line Sec. 19-21S-35W KEARNEY COUNTY, KANSAS
 COMMENCED: 2-21-66
 COMPLETED: 3-12-66

0	40	Surface Soil
40	185	Clay, Sand
185	807	Blue Shale
807	1260	Shale
1260	1500	Redbed, Sand
1500	1530	Redbed
1530	1795	Sand, Shells
1795	1929	Shale, Shells
1929	2225	Redbed, Shells
2225	2240	Anhydrite
2240	2590	Shale, Shells
2590	2795	Shale, Lime
2795	2825	Lime
2825	2930	Lime, Shale
2930	4555	Lime
4555	4645	Coring
4645	4700	Lime
	<u>4700</u>	<u>RTD - D. & A.</u>

RECEIVED
 STATE CORPORATION COMMISSION
 MAR 16 1966
 CONSERVATION DIVISION
 Topeka, Kansas

Set 8 5/8" new J-55 24# casing @ 1260' cemented with 265 sacks Common cement with 1/4# floreal, 2% cc and 294 cubic feet of Diacel "D" and 50 sacks Common with 2% cc

I, Leslie Kite, do hereby certify that the above and foregoing is a true and correct copy of the log of the Arlene B-#1 well, located 1980' from South Line and East Line of Section 19, Township 21 South, Range 35 West, Kearney County, Kansas, as reflected by the records of Leben Drilling, Inc.

Leslie Kite

 Leslie Kite

STATE OF KANSAS)
) SS
 COUNTY OF BARTON)

Subscribed and sworn to and before me, a Notary Public, in and for Barton County, Kansas, this 14th day of March, 1966.

Ulanda Nichols

 Ulanda Nichols

My Commission Expires:
 April 1, 1967