

STATE OF KANSAS
STATE CORPORATION COMMISSION

Form CP-4

Give All Information Completely
Make Required Affidavit
Mail or Deliver Report to:
Conservation Division
State Corporation Commission
212 No. Market
Wichita, Kansas 67202

WELL PLUGGING RECORD

McPherson County, Sec. 9 Twp. 21 Rge. 3 (E) W (W)

Location as "NE/CNW/SW" or footage from lines NW/4 475' So. No. line & w. of E. Line

Lease Owner Donald T. Ingling et al
Lease Name Voshell Estate Well No. 1
Office Address 615 First National Bldg., Wichita, Kans. 67202

Character of Well (completed as Oil, Gas or Dry Hole) oil
Date well completed 9-21 19 66
Application for plugging filed 4-30 19 70
Application for plugging approved 5-1 19 70
Plugging commenced May 10 19 70
Plugging completed May 11 19 70
Reason for abandonment of well or producing formation no production

If a producing well is abandoned, date of last production 19
Was permission obtained from the Conservation Division or its agents before plugging was commenced? Yes

Name of Conservation Agent who supervised plugging of this well Hugh Scott
Producing formation _____ Depth to top _____ Bottom _____ Total Depth of Well 3383 Feet
Show depth and thickness of all water, oil and gas formations.

OIL, GAS OR WATER RECORDS

CASING RECORD

FORMATION	CONTENT	FROM	TO	SIZE	PUT IN	PULLED OUT
				8-5/8	235	none
				5 1/2	3382	2308

Describe in detail the manner in which the well was plugged, indicating where the mud fluid was placed and the method or methods used in introducing it into the hole. If cement or other plugs were used, state the character of same and depth placed, from _____ feet to _____ feet for each plug set.

Sanded back to 3325'. Dumped 5 sacks of cement from 3325' to 3280'.
Shot pipe off at 2308.30'. Pulled pipe and mudded hole to 3280'.
to 260'. Set rock bridge from 260' to 240' and finished
filling hole with ready mix cement.

RECEIVED
STATE CORPORATION COMMISSION
JUN 26 1970
CONSERVATION DIVISION
Wichita, Kansas

Name of Plugging Contractor Bert Self
Address Hutchinson, Kans.

STATE OF Kansas, COUNTY OF Reno, ss.
Employee (employee of owner) or (owner or operator) of the above-described

well, being first duly sworn on oath, says: That I have knowledge of the facts, statements, and matters herein contained and the log of the above-described well as filed and that the same are true and correct. So help me God.


(Signature) Bert Self
R. R. #4, Hutchinson, Kans. 67501
(Address)

Subscribed and Sworn to before me this 12th day of May, 1970


October 18, 1973

Notary Public.

T
Z
S

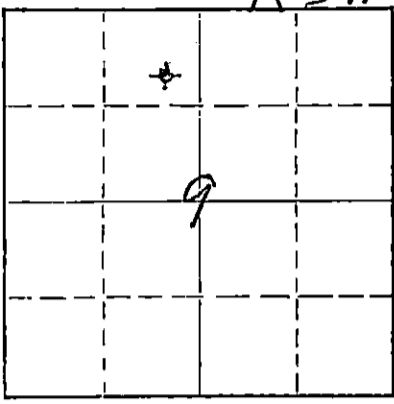

Locate well correctly on above Section Plat

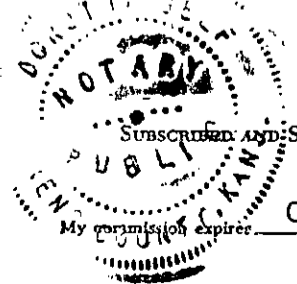

WELL-LOG--VOSHELL ESTATE NO. 1

Donald T. Ingling et al, Lease Owner

Section 9-21-3W

Donald T. Ingling, Contractor

Location: NW/4 475' So No line & 330' W of E line

Commenced: 9-7-66

Completed: 9-21-66

County: McPherson

Total Depth: 3383' (rotary)

Production:

Casing: 8 5/8" 235' (150 sacks cement)
5 1/2" 3382' (100 sacks cement)

Elevation: 1477' RB

Figures below indicate bottom formation

45	surface clay	3370	sand
160	shale and sand	3378	sand and shale
235	shale and shells	3380	sand
250	shale and shells	3382	sand
480	shale and shells	3383	sand
720	shale and lime	3383	Total Depth
950	shale and lime		
1225	lime		
1255	lime and shale		
1535	shale and shells		
1580	shale and lime		
1760	lime and shale		
1920	lime		
2034	lime		
2145	lime		
2380	lime		
2471	lime		
2540	lime and shale		
2645	lime		
2695	lime		
2755	lime		
2833	lime		
2895	lime and shale		
2985	lime and shale		
3075	shale and lime shells		
3145	shale and lime shells		
3225	shale and lime		
3285	shale		
3288	shale		
3320	shale and sand		
3330	lime		
3362	shale and sand		

I certify this ks a true and correct copy of the above mentioned well.

STATE OF KANSAS)
) SS.
SEDGWICK COUNTY)

D. T. Ingling

Subscribed and sworn to before me, a Notary Public, in said county and state.

My commission expires: Feb. 27, 1968.

M. E. Beach
Notary Public