

CARD MUST BE TYPED

State of Kansas  
NOTICE OF INTENTION TO DRILL

CARD MUST BE SIGNED

(see rules on reverse side)

Starting Date: 8 6 84  
month day year

API Number 15- 097-21,053-0000

OPERATOR: License # 9668  
Name Imperial Oil & Gas, Inc.  
Address 720 Fourth Financial Center  
City/State/Zip Wichita, Kansas 67202  
Contact Person Barbara Waitt  
Phone 316/263-5205

C NE NW Sec 26 Twp 28 S, Rge 17  
(location)  East  West

3300 4620 Ft North from Southeast Corner of Section  
4620 3300 Ft West from Southeast Corner of Section  
(Note: Locate well on Section Plat on reverse side)

CONTRACTOR: License # 5302  
Name Red Tiger Drilling Company  
City/State Wichita, Kansas

Nearest lease or unit boundary line 330 feet.  
County Kiowa  
Lease Name WHEELER Well# 1-26

Well Drilled For: Well Class: Type Equipment:  
 Oil  Swd  Infield  Mud  Air Rotary  
 Gas  Inj  Pool Ext.  Cable  
 OWWO  Expl  Wildcat

THIS PERMIT  
JAN 20 1985

Domestic well within 330 feet:  yes  no  
Municipal well within one mile:  yes  no

If OWWO: old well info as follows:

Operator  
Well Name  
Comp Date Old Total Depth  
Projected Total Depth 4800 feet  
Projected Formation at TD  
Expected Producing Formations

Depth to Bottom of fresh water 200 feet  
Lowest usable water formation Cheyenne Sandstones  
Depth to Bottom of usable water 200 feet  
Surface pipe by Alternate:  1  2

Surface pipe to be set 450 feet  
Conductor pipe if any required feet  
Ground surface elevation feet MSL  
This Authorization Expires  
Approved By Dwa Lee 7-20-84

I certify that we will comply with K.S.A. 55-101, et seq., plus eventually plugging hole to K.C.C. specifications.


Date 7/18/84 Signature of Operator or Agent Robert [Signature] Title Vice President

MHC/WOHE 7-20-84

Must be filed with the K.C.C. five (5) days prior to commencing well  
 This card void if drilling not started within six (6) months of date received by K.C.C.

**Important procedures to follow :**

**A Regular Section of Land**  
**1 Mile = 5,280 Ft.**

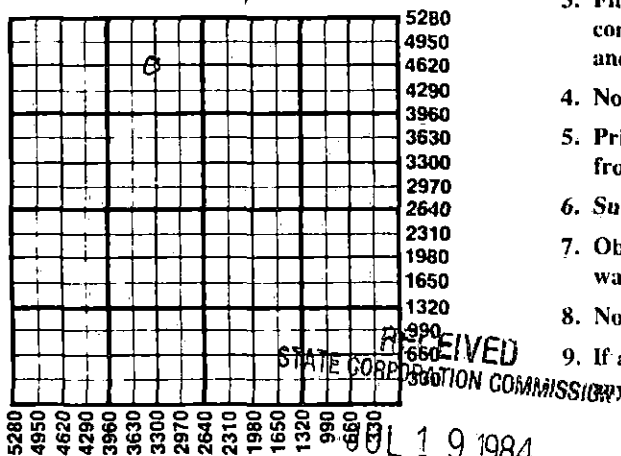

1. Notify District office before setting surface casing.
2. Set surface casing by circulating cement to the top.
3. File completion forms ACO-1 with K.C.C. within 90 days of well completion, following instructions on ACO-1, side 1, and including copies of wireline logs.
4. Notify District office 48 hours prior to old well workover or re-entry.
5. Prior to plugging, prepare a plugging plan, then obtain agreement from the appropriate district office for an approved plugging plan.
6. Submit plugging report (CP-4) to K.C.C. after plugging is completed.
7. Obtain an approved injection docket number before disposing of salt water.
8. Notify K.C.C. within 10 days when injection commences or terminates.
9. If an alternate 2 completion, cement in the production pipe from below usable water to surface within 120 days of spud date.

CONSERVATION DIVISION  
 Wichita, Kansas

7-19-84

State Corporation Commission of Kansas  
 Conservation Division  
 200 Colorado Derby Building  
 Wichita, Kansas 67202  
 (316) 263-3238