

WELL PLUGGING RECORD


Give All Information Completely  
Make Required Affidavit  
Mail or Deliver Report to:  
Conservation Division  
State Corporation Commission  
211 No. Broadway  
Wichita, Kansas

Hamilton

County, Sec. 35 Twp. 21 Rge. 41W (E) (W)  
C - NW - SE

Location as "NE/CNW/SW" or footage from lines  
Lease Owner Livingston Oil Company  
Lease Name 3511 B Well No. 1  
Office Address Box 1797, Tulsa, Oklahoma  
Character of Well (completed as Oil, Gas or Dry Hole) Dry Hole  
Date well completed 12-20 19 64  
Application for plugging filed 11-28 19 66  
Application for plugging approved 12-1 19 66  
Plugging commenced 2 - 17 19 67  
Plugging completed 2 - 18 19 67  
Reason for abandonment of well or producing formation

NORTH

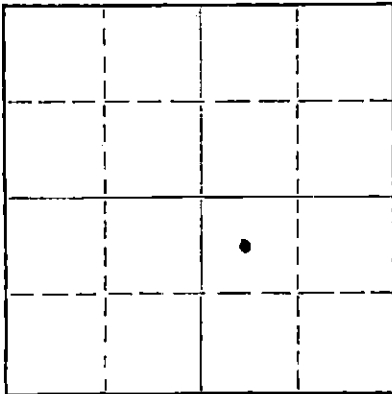

Locate well correctly on above Section Plat

If a producing well is abandoned, date of last production 19  
Was permission obtained from the Conservation Division or its agents before plugging was commenced? Yes

Name of Conservation Agent who supervised plugging of this well Ed Eves  
Producing formation Depth to top Bottom Total Depth of Well 2772 Feet  
Show depth and thickness of all water, oil and gas formations.

OIL, GAS OR WATER RECORDS

CASING RECORD

FORMATION	CONTENT	FROM	TO	SIZE	PUT IN	PULLED OUT
				8 5/8	169	0
				4 1/2	2772	2221

Describe in detail the manner in which the well was plugged, indicating where the mud fluid was placed and the method or methods used in introducing it into the hole. If cement or other plugs were used, state the character of same and depth placed, from feet to feet for each plug set.

Mix 10 sacks cement w/hulls to plug off perforrations at 2742. Stop plug at 2640 feet. Shoot pipe loose at 2221 feet and pull same to 600 feet. Spot 25 sacks cement at 600 to 525 feet. Mud at 525 to 170' and 20 sacks cement at 170 to 115 feet. Mud 115 to 40' and plug and 10 sacks cement at 40' to 0 feet.

RECEIVED  
STATE CORPORATION COMMISSION

MAR 13 1967

CONSERVATION DIVISION  
Wichita, Kansas

(If additional description is necessary, use BACK of this sheet)  
Name of Plugging Contractor Sargent's Casing Pulling Service  
Address Box 506 Liberal, Kansas

STATE OF Oklahoma, COUNTY OF Tulsa, ss.  
Boyd Phillips (employee of owner) or (owner or operator) of the above-described well, being first duly sworn on oath, says: That I have knowledge of the facts, statements, and matters herein contained and the log of the above-described well as filed and that the same are true and correct. So help me God.

(Signature) Boyd Phillips

SUBSCRIBED AND SWORN TO before me this 10th day of March, 1967

My Commission Expires AUGUST 10, 1969  
Margaret Heath  
Notary Public.