

15.075.10015.0000

STATE OF KANSAS
STATE CORPORATION COMMISSION

WELL PLUGGING RECORD

Give All Information Completely
Make Required Affidavit
Mail or Deliver Report to
Conservation Division
State Corporation Comm.
245 North Water
Wichita, KS 67202

Hamilton County, Sec. 32 Twp. 21 Rge. 41 E/W
Location as "NE/CNW $\frac{1}{4}$ SW $\frac{1}{4}$ " or footage from lines
NW-SE

Lease Owner Midwest Casing Pulling
Lease Name HCU Well No. 3211

Office Address Bx. F, Sublette, Ks. 67877

Character of Well (Completed as Oil, Gas or Dry Hole)
Gas

Date Well completed 5-2 1982

Application for plugging filed 4-27 1979

Application for plugging approved 5-1 1979

Plugging commenced 5-26 1979


Plugging completed 5-29 1979

Reason for abandonment of well or producing formation
Hole in casing

If a producing well is abandoned, date of last production
19

Was permission obtained from the Conservation Division or
its agents before plugging was commenced? yes

Name of Conservation Agent who supervised plugging of this well Mr. Thomas
Producing formation Winfield Depth to top 2770 Bottom 2780 Total Depth of Well 2805'
Show depth and thickness of all water, oil and gas formations.

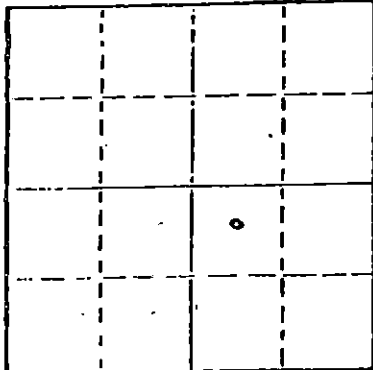

Locate well correctly on above
Section Plot

OIL, GAS OR WATER RECORDS

CASING RECORD

FORMATION	CONTENT	FROM	TO	SIZE	PUT IN	PULLED OUT
Surface				8 5/8"	189'	0'
Production				4 1/2"	2801'	1670'

Describe in detail the manner in which the well was plugged, indicating where the mud fluid was placed and the method or methods used in introducing it into the hold. If cement or other plugs were used, state the character of same and depth placed, from feet to feet for each plug set.

Sanded up to 1670'

Displaced to 240'

Pumped 35 sks. cement 240' to 140'

Displaced 140' to 40'

Put bridge & 10 sks. cement 40' to 0

Cut off 8 5/8", 3' below Ground level

RECEIVED
STATE CORPORATION COMMISSION

JUN 13 1979

(If additional description is necessary, use BACK of this sheet)

Name of Plugging Contractor Midwest Casing Pulling, Box F, Sublette, Ks. 67877

STATE OF Kansas COUNTY OF Haskell, ss.
I, Edgar J. Eves (employee of owner) or (owner or operator)

of the above-described well, being first duly sworn on oath, says: That I have knowledge of the facts, statements, and matters herein contained and the log of the above-described well as filed and that the same are true and correct. So help me God.

(Signature)

Edgar J. Eves
Box F, Sublette, Ks. 67877

(Address)

SUBSCRIBED AND SWORN TO before me this 30th day of May, 1979

Sondra L. Eves

Notary Public.

My commission expires 12-6-80

