


Give All Information Completely
Make Required Affidavit
Mail or Deliver Report to:
Conservation Division
State Corporation Commission
800 Bittling Building
Wichita, Kansas

WELL PLUGGING RECORD

NORTH

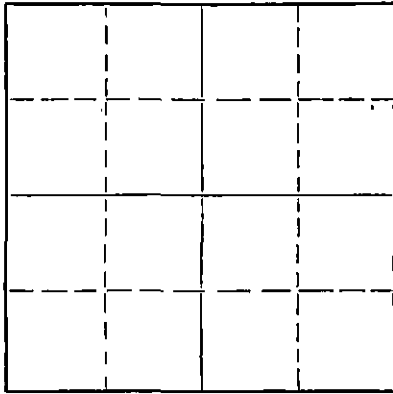

Locate well correctly on above
Section Flat

Pawnee County. Sec. 1 Twp. 21 Rge. (E) 15 (W)
Location as "NE/CNW/SW" or footage from lines C E/2 SW NE/4
Lease Owner M. B. Armer
Lease Name English "A" Well No. 1
Office Address 710 Petroleum Building, Wichita 2, Kansas
Character of Well (completed as Oil, Gas or Dry Hole) dry
Date well completed Oct. 28, 19 52
Application for plugging filed Oct. 28, 19 52
Application for plugging approved Oct. 28, 19 52
Plugging commenced Oct. 28, 19 52
Plugging completed Oct. 28, 19 52
Reason for abandonment of well or producing formation dry

If a producing well is abandoned, date of last production 19
Was permission obtained from the Conservation Division or its agents before plugging was commenced? Yes

Name of Conservation Agent who supervised plugging of this well M. A. Rives
Producing formation _____ Depth to top _____ Bottom _____ Total Depth of Well 3770 Feet
Show depth and thickness of all water, oil and gas formations.

OIL, GAS OR WATER RECORDS

CASING RECORD

FORMATION	CONTENT	FROM	TO	SIZE	PUT IN	PULLED OUT
				8-5/8"	886	None

Describe in detail the manner in which the well was plugged, indicating where the mud fluid was placed and the method or methods used in introducing it into the hole. If cement or other plugs were used, state the character of same and depth placed, from _____ feet to _____ feet for each plug set.

Filled hole with heavy rotary mud to 300 ft.
set plug and run 20 sacks cement through drill
pipe. Filled with mud to 35 ft. and set plug
and run 10 sacks cement at the surface.

RECEIVED
STATE CORPORATION COMMISSION
NOV 11 1952
CONSERVATION DIVISION
WICHITA, KANSAS

11-11-52

(If additional description is necessary, use BACK of this sheet)
Name of Plugging Contractor M. B. Armer
Address 710 Petroleum Bldg., Wichita 2, Kansas

STATE OF Kansas, COUNTY OF Sedgwick, ss.
L. C. Sponenberg (employee of owner) or (~~owner~~) of the above-described well, being first duly sworn on oath, says: That I have knowledge of the facts, statements, and matters herein contained and the log of the above-described well as filed and that the same are true and correct. So help me God.

(Signature) L. C. Sponenberg
(Address) _____

SUBSCRIBED AND SWORN TO before me this 10 day of November, 19 52
Lorraine M Johnson
Notary Public.

My commission expires Oct. 13, 1956.

PLUGGING
FILE SEC 1 T 21 R 15
BOOK PAGE 56 LINE 2

LOG

Company: M. B. Armer
Contractor: M. B. Armer
Drilling Commenced: 10/16/52
Drilling Completed: 10/28/52
Elevation: 1944 R.B.
1942 D.F.

Farm: English #1-A
Location: C E/2 SW NE 1-21-15 W
Pawnee County, Kans.
Casing Record: 8-5/8" casing at 886'
with 400 cu. ft. Pozmix.

(figures below indicate bottoms)

Sand & Gravel	200
Blue Sticky Shale & Clay	205
Sticky Shale	320
Sand, Shale & Iron	415
Red Bed & Shale	470
Red Bed & Shells	875
Anhydrite & Shale	886
Anhydrite	900
Shale & Shells	1335
Shale, Salt & Shells	1765
Shale & Shells	1890
Lime "Sandy"	1980
Lime & Shale	3092
Lime	3100
Shale & Lime	3662
Arb. Lime	3710
Lime	3770
R.F.D.	3770

FORMATION TOPS (E.B. Meas.)

Heebner	3225
Brown Lime	3330
Kansas City	3344
Viola	3599
Simpson	3618
Arbuckle	3658

I hereby certify that this is a true and correct log of the above described well as shown by the drilling reports.

M. B. ARMER

RECEIVED
STATE COMMISSION

By *[Signature]*

STATE OF KANSAS
COUNTY OF SEDGWICK

Subscribed and sworn to before me, a notary public, in and for said County and State this 31st day of October, 1952.

[Signature]
Notary Public

My Commission Expires: Sept. 17, 1955.

PLUGGING
FILE SEC 1 T 21 R 15 W
BOOK PAGE 56 LINE 2