

STATE OF KANSAS
STATE CORPORATION COMMISSION

WELL PLUGGING RECORD

Give All Information Completely
Make Required Affidavit
Mail or Deliver Report to:
Conservation Division
State Corporation Commission
809 Bittling Building
Wichita, Kansas


OR
FORMATION PLUGGING RECORD

Strike out upper line
when reporting plug-
ging off formations.

Pawnee County. Sec. 1 Twp. 21S Rge. 15W (E) (W)
Location as "NE 1/4 NW 1/4 SW 1/4" or footage from lines. SW 1/4 NE 1/4 NW 1/4

Lease Owner. Continental Oil Co.
Lease Name. Chennell Well No. 1
Office Address. Ponca City, Oklahoma

Character of Well (completed as Oil, Gas or Dry Hole). Stratigraphic test
Date well completed. Oct. 18, 1944
Application for plugging filed. Oct. 18, 1944
Application for plugging approved. Oct. 18, 1944
Plugging commenced. Oct. 18, 1944
Plugging completed. Oct. 20, 1944
Reason for abandonment of well or producing formation.

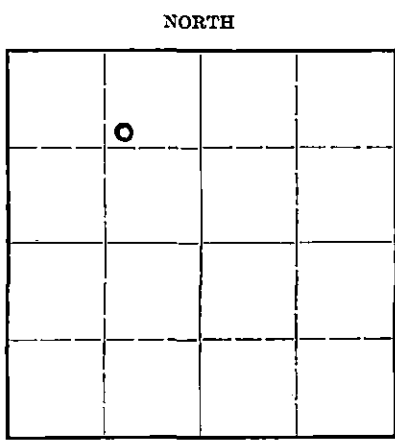

Locate well correctly on above
Section Plat

If a producing well is abandoned, date of last production. 19
Was permission obtained from the Conservation Division or its agents before plugging was com-
menced? Yes

Name of Conservation Agent who supervised plugging of this well. Mr. Kerr
Producing formation. Depth to top. Bottom. Total Depth of Well. Feet
Show depth and thickness of all water, oil and gas formations.


OIL, GAS OR WATER RECORDS

CASING RECORD

Formation	Content	From	To	Size	Put In	Pulled Out
				8 5/8"	435 ft.	none

Describe in detail the manner in which the well was plugged, indicating where the mud fluid was placed and the method or methods used in introducing it into the hold. If cement or other plugs were used, state the character of same and depth placed, from feet to feet for each plug set.

The hole was filled with heavy mud to 420 ft. where a wood plug was set and cemented with 25 sacks of cement and 25 sacks of Cal-seal through the drill pipe. The hole was then filled to 25 feet where another plug was set and cemented to the top of the hole.

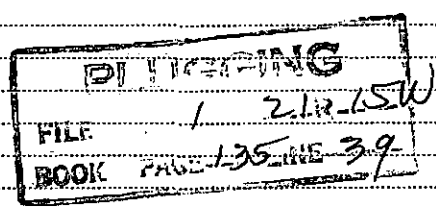

(If additional description is necessary, use BACK of this sheet)

Correspondence regarding this well should be addressed to J. George Klein
Address. Box 183 Great Bend, Kansas

STATE OF Kansas COUNTY OF Barton, ss.
J. George Klein (employee of owner) or () of the above-described well,

being first duly sworn on oath, says: That I have knowledge of the facts, statements, and matters herein contained and the log of the above-described well as filed and that the same are true and correct. So help me God

(Signature) J. George Klein
Great Bend, Kansas (Address)

SUBSCRIBED AND SWORN to before me this 16 day of November

My commission expires February 7-1946

