


WELL PLUGGING RECORD

Give All Information Completely.
Make Required Affidavit
Mail or Deliver Report to:
Conservation Division
State Corporation Commission
900 Bitting Building
Wichita, Kansas

NORTH

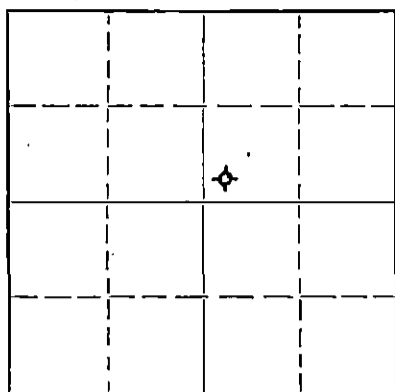

Locate well correctly on above Section Plat

Pawnee County. Sec. 1 Twp. 21 Rge. 15 (E) West(W)
Location as "NE/CNW $\frac{1}{4}$ /SW $\frac{1}{4}$ " or footage from lines SW SW NE
Lease Owner Max Cohen
Lease Name English Estate Well No. 1
Office Address 203 Brown Bldg. - Wichita, Kansas
Character of Well (completed as Oil, Gas or Dry Hole) dry hole
Date well completed Sept. 1941 19
Application for plugging filed 1-18-52 19
Application for plugging approved Jan. 23, 1952 19
Plugging commenced 1-18-52 19
Plugging completed 1-20-52 19
Reason for abandonment of well or producing formation dry

If a producing well is abandoned, date of last production 19
Was permission obtained from the Conservation Division or its agents before plugging was commenced? Yes

Name of Conservation Agent who supervised plugging of this well C. D. Stough
Producing formation Depth to top Bottom Total Depth of Well 3658 Feet
Show depth and thickness of all water, oil and gas formations.


OIL, GAS OR WATER RECORDS

CASING RECORD

Formation	Content	From	To	Size	Put In	Pulled Out
				5-1/2"	3657'	2470'
				8-5/8"	870'	

Describe in detail the manner in which the well was plugged, indicating where the mud fluid was placed and the method or methods used in introducing it into the hole. If cement or other plugs were used, state the character of same and depth placed, from feet to feet for each plug set.

Pumped in 100 sacks of Baroid mud. Mudded hole to 260', set 10' rock bridge and ran 20 sacks of cement at 250'. Mudded hole to 18' and ran 5 sacks of cement. Plugging completed.

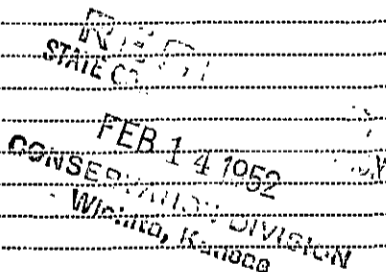

(If additional description is necessary, use BACK of this sheet)

Name of Plugging Contractor West Supply Company
Address Chase, Kansas


STATE OF Kansas, COUNTY OF Sedgwick, ss.
Max Cohen (employee of owner) or (owner or operator) of the above-described well,
being first duly sworn on oath, says: That I have knowledge of the facts, statements, and matters herein contained and the log of the above-described well as filed and that the same are true and correct. So help me God.

(Signature) Max Cohen
203 Brown Bldg., Wichita, Kansas
(Address)

SUBSCRIBED AND SWORN TO before me this 12 day of Feb., 1952.

My commission expires Jan 31, 1955

Jack Paulsen Notary Public.

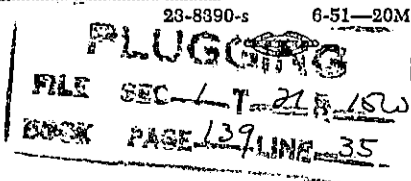


MAX COHEN
English Estate No. 1.

SEC.1 T.21 R. 15 W
SWc NE

Total Depth. 3658'
Comm. 8-3-41 Comp. 10-18-41
% of or Treated.
Contractor. Hannum Drlg.Co.
Issued. 12-27-41

County. Pawnee

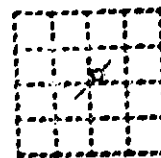

CASING:
8 5/8" 870'
5 1/2" 3657' DFM

Elevation.

Production. Dry

Figures Indicate Bottom of Formations.

sand	147	
shale & shells	210	
shale blue	360	
sand	390	
shale blue	410	
shale blue sticky	490	
sand	540	
red rock, shale, shells	864	Anhydrite 864
anhydrite	895	Heebner 3211
red rock & shale	965	Lansing 3330
shale & shells	1025	Voila 3582
red rock	1135	Simpson 3600
shale & shells	1320	Arbuckle 3640
salt & shale	1580	
shale	1600	
anhydrite	1740	
anhydrite & shale	1820	
lime	1885	
shale & red bed	1895	
lime sdy	2070	
lime sdy brk.	2255	
lime sdy	2495	
shale	2555	
lime sdy	2580	
brk. lime & shale	2828	
lime sdy	2862	
shale	2875	
brk lime & shale	3000	
lime	3122	
lime brk	3210	
shale	3246	
lime	3270	
shale	3335	
shale & lime	3340	
lime	3600	
shale	3640	
lime	3658	
Total Depth.		

PLUGGING
FILE SEC. 1 T. 21 R. 15 W
BOOK PAGE 139 LINE 35