


WELL PLUGGING RECORD

Give All Information Completely
Make Required Affidavit
Mail or Deliver Report to:
Conservation Division
State Corporation Commission
211 No. Broadway
Wichita, Kansas

Pawnee County, Sec. 1 Twp. 21 Rge. 15 (E) (W) W

Location as "NE/CNW/SW" or footage from lines C SW NW NE
Lease Owner C-G Drilling Co. & Houston Petroleum Co.
Lease Name Weathers Well No. 1
Office Address 107 Rule Building, Wichita 2, Kansas
Character of Well (completed as Oil, Gas or Dry Hole) Dry Hole
Date well completed September 24 1960
Application for plugging filed September 24 1960
Application for plugging approved September 24 1960
Plugging commenced September 24 1960
Plugging completed September 24 1960
Reason for abandonment of well or producing formation Too low structurally

NORTH

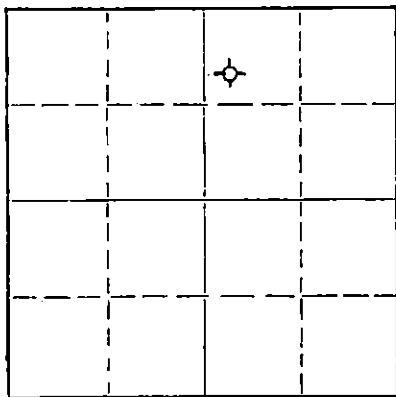

Locate well correctly on above
Section Plat

If a producing well is abandoned, date of last production 19
Was permission obtained from the Conservation Division or its agents before plugging was commenced? Yes

Name of Conservation Agent who supervised plugging of this well Eldon Petty, Hays, Kansas
Producing formation _____ Depth to top _____ Bottom _____ Total Depth of Well 3573 Feet
Show depth and thickness of all water, oil and gas formations.

OIL, GAS OR WATER RECORDS

CASING RECORD

FORMATION	CONTENT	FROM	TO	SIZE	PUT IN	PULLED OUT
				8-5/8"	890.70'	None

Describe in detail the manner in which the well was plugged, indicating where the mud fluid was placed and the method or methods used in introducing it into the hole. If cement or other plugs were used, state the character of same and depth placed, from _____ feet to _____ feet for each plug set.

Filled hole with heavy mud to 350'. Set plug. Put in 20 sacks cement. Filled with heavy mud up to 40'. Set plug. Filled to top with 1/2 sack hulls and 10 sacks cement.

RECEIVED
STATE CORPORATION COMMISSION
SEP 29 1960
CONSERVATION DIVISION
Wichita, Kansas

(If additional description is necessary, use BACK of this sheet)
Name of Plugging Contractor C-G Drilling Co.
Address 107 Rule Building, Wichita 2, Kansas


STATE OF KANSAS COUNTY OF SEDGWICK, ss.
G. F. Galloway (employee of owner) or (owner or operator) of the above-described well, being first duly sworn on oath, says: That I have knowledge of the facts, statements, and matters herein contained and the log of the above-described well as filed and that the same are true and correct. So help me God.

(Signature) G. F. Galloway
107 Rule Building
(Address)

SUBSCRIBED AND SWORN TO before me this 27th day of September, 1960

My commission expires May 20, 1963

Vicky Jacobs
Notary Public.

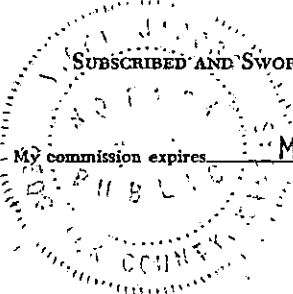

WELL LOG

OPERATOR C-G Drilling Co. & Houston Petroleum Co. SEC. 1-21-15W
 WELL NAME Weathers #1 LOC. C SW NW NE
 TOTAL DEPTH 3573' COUNTY Pawnee
 COMM. September 12, 1960 COMP. September 24, 1960 STATE Kansas
 RIG NO. 2 ELEVATION 1941' KB

CASING: Ran 890.70' (29 jts.) 8-5/8" OD Surface Casing. PRODUCTION: D & A

All measurements taken from the top of rotary bushing.

FROM	TO	FORMATION	DEVIATION FROM VERTICAL	REMARKS:
0	245	Sand		
245	290	Shale		
290	405	Sand		
405	860	Red Bed		
860	886	Anhydrite		
886	1630	Shale-Shell		
1630	2795	Shale-Lime	0° - 2500	
2795	3568	Lime	0° - 2750	DST 3340-3365'
3568	3573	Granite	0° - 3000	DST 3390-3485'
			0° - 3250	
			0° - 3500	

RECEIVED
 STATE CORPORATION COMMISSION
 SEP 29 1960
 CONSERVATION DIVISION
 Wichita, Kansas

STATE OF KANSAS }
 COUNTY OF SEDGWICK } SS.

The undersigned hereby certifies that to the best of his knowledge and belief, the above facts are true and correct.

C-G DRILLING CO.
 By G. F. Galloway
 G. F. Galloway

SUBSCRIBED AND SWORN TO, BEFORE ME, THIS 27th day of September, 1960

My commission expires:
 May 20, 1963

Vicky Jacobs
 Vicky Jacobs - Notary public

