

STATE OF KANSAS  
STATE CORPORATION COMMISSION

Give All Information Completely  
Make Required Affidavit  
Mail or Deliver Report to:  
Conservation Division  
State Corporation Commission  
211 No. Broadway  
Wichita, Kansas

WELL PLUGGING RECORD

Hodgeman County. Sec. 24 Twp. 21S Rge. (E) 21 (W)

Location as "NE/CNW/SW" or footage from lines C SE NW

Lease Owner Clinton Oil Company

Lease Name EAKIN "A" Well No. 1

Office Address 6810 West Highway 54, Wichita, Kansas

Character of Well (completed as Oil, Gas or Dry Hole) Dry Hole

Date well completed October 21 19 63

Application for plugging filed October 21 19 63

Application for plugging approved October 21 19 63


Plugging commenced October 21 19 63

Plugging completed October 21 19 63

Reason for abandonment of well or producing formation Dry Hole

If a producing well is abandoned, date of last production 19

Was permission obtained from the Conservation Division or its agents before plugging was commenced? Yes

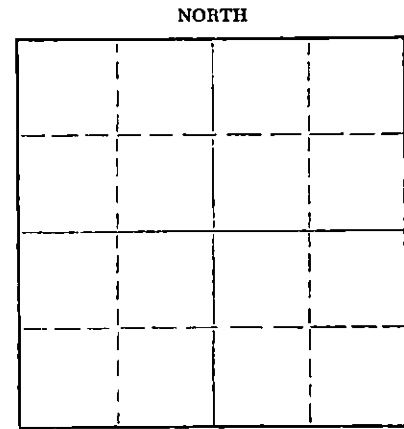

Locate well correctly on above Section Plat

Name of Conservation Agent who supervised plugging of this well Hugh Scott, Sublett, Kansas

Producing formation Depth to top Bottom Total Depth of Well Feet

Show depth and thickness of all water, oil and gas formations.

OIL, GAS OR WATER RECORDS

CASING RECORD

FORMATION	CONTENT	FROM	TO	SIZE	PUT IN	PULLED OUT
			279	8 5/8		

Describe in detail the manner in which the well was plugged, indicating where the mud fluid was placed and the method or methods used in introducing it into the hole. If cement or other plugs were used, state the character of same and depth placed, from feet to feet for each plug set.

Pump truck by Sun Cementing Company. Plug at 750 feet, 35 sacks through drill pipe. Mud to 250 feet. Plug at 250 feet, 35 sacks through drill pipe. Mud to 40 feet. Wired plug at 40 feet. 1/2 sack of hulls and 13 sacks of cement. Plugged rat hole with 2 sacks of hulls, and 2 sacks of cement. Well plugged October 21, 1963.

RECEIVED  
STATE CORPORATION COMMISSION

OCT 28 1963

CONSERVATION DIVISION  
Wichita, Kansas

Name of Plugging Contractor Garvey Drilling Company  
Address Great Bend, Kansas

STATE OF Kansas, COUNTY OF Sedgwick, ss.

Wayne Hamilton (employee of owner) or (owner or operator) of the above-described well, being first duly sworn on oath, says: That I have knowledge of the facts, statements, and matters herein contained and the log of the above-described well as filed and that the same are true and correct. So help me God.

(Signature) Wayne Hamilton

6810 West Highway 54 (Address)

SUBSCRIBED AND SWORN to before me this 23 day of October, 1963

My commission expires 12-31-65 Betty Jernshell Notary Public.

# WELL LOG

15.083.10033.0000

COMPANY Clinton Oil Co.

SEC. 24 T. 21S. 21W

FARM Eakin

NO. "A" #1

LOC. C SE NW


TOTAL DEPTH 4335'

COUNTY Hodgeman

COMM. 10-10-63

COMP. 10-21-63

CONTRACTOR Garvey Drilling Company

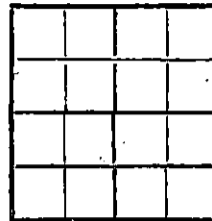

CASING 8 5/8" @ 279' w/225 SX

ELEVATION

PRODUCTION

FIGURES INDICATE BOTTOM OF FORMATIONS

- 45' Surface Clay
- 120' Sand and Shale
- 430' Blue Shale
- 598' Red Bed
- 615' Anhydrite
- 700' Red Bed
- 1258' Sand and Red Bed
- 1315' Anhydrite and Shale
- 1500' Shale
- 1780' Shale and Lime Stringers
- 2110' Shale and Lime
- 2925' Lime and Shale
- 3370' Shale and Lime
- 3490' Lime and Shale
- 3530' Lime, Shale, and Chalk
- 3710' Shale and Lime
- 3805' Lime Lansing
- 3861' Lime
- 3910' Shale, Lime and Chalk
- 4259' Lime and Shale
- 4335' Lime and Chert
- 4335' RTD

RECEIVED  
STATE CORPORATION COMMISSION

NOV 8 1963

CONSERVATION DIVISION  
Wichita, Kansas

State of Kansas }  
County of Barton } SS

I, Sam N. Stephens of Garvey Drilling Company

upon oath state the above and foregoing is a true and correct copy of the log of the Eakin A-1 well.

*Sam N. Stephens*

Subscribed and sworn to before me this 24th day of October 19 63

My Commission Expires: September 23rd, 1967

*Edward E. Lewis*  
NOTARY PUBLIC