


STATE OF KANSAS
STATE CORPORATION COMMISSION

Form CP-4

WELL PLUGGING RECORD

Give All Information Completely
Make Required Affidavit
Mail or Deliver Report to:
Conservation Division
State Corporation Commission
211 No. Broadway
Wichita, Kansas

Hodgeman County. Sec. 28 Twp. 21S Rge. 25 ~~XX~~ (W)
Location as "NE/CNW/SW" or footage from lines C SW NW
Lease Owner Stelbar Oil Corporation, Inc.
Lease Name Sinclair "A" Well No. 1
Office Address 310 Petroleum Building, Wichita, Kansas
Character of Well (completed as Oil, Gas or Dry Hole) Dry Hole
Date well completed August 30, 1965 19 65
Application for plugging filed September 10, 19 65
Application for plugging approved September 10, 19 65
Plugging commenced August 30, 19 65
Plugging completed August 30, 19 65
Reason for abandonment of well or producing formation Dry

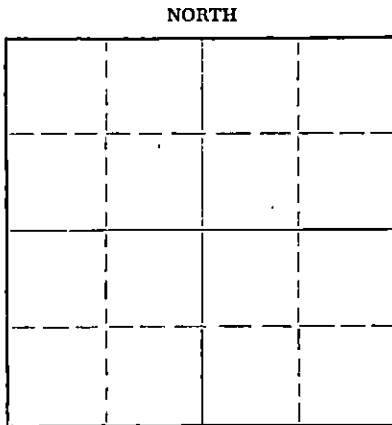

Locate well correctly on above Section Flat

If a producing well is abandoned, date of last production _____ 19 ____
Was permission obtained from the Conservation Division or its agents before plugging was commenced? Yes

Name of Conservation Agent who supervised plugging of this well Hugh Scott
Producing formation _____ Depth to top _____ Bottom _____ Total Depth of Well 4587 Feet
Show depth and thickness of all water, oil and gas formations.

OIL, GAS OR WATER RECORDS

CASING RECORD

FORMATION	CONTENT	FROM	TO	SIZE	PUT IN	PULLED OUT
				8-5/8"	271	None

Describe in detail the manner in which the well was plugged, indicating where the mud fluid was placed and the method or methods used in introducing it into the hole. If cement or other plugs were used, state the character of same and depth placed, from _____ feet to _____ feet for each plug set.
Plugged hole with pump truck
Plug #1 - spotted 25 sacks at 700'
Plug #2 - pushed plug to 300' and spotted 25 sacks
Plug #3 - pushed plug to 45' with 1/2 sack hulls and then spotted 15 sacks at 45'
Plug #4 - 2 sacks in rathole

RECEIVED
STATE CORPORATION COMMISSION
SEP 13 1965
CONSERVATION DIVISION
Wichita, Kansas

(If additional description is necessary, use BACK of this sheet)
Name of Plugging Contractor S & S Drilling Company
Address Box 645, Great Bend, Kansas

STATE OF KANSAS, COUNTY OF SEDGWICK, ss.
Bertrand M. Lester, Jr. (employee of owner) or (owner or operator) of the above-described well, being first duly sworn on oath, says: That I have knowledge of the facts, statements, and matters herein contained and the log of the above-described well as filed and that the same are true and correct. So help me God.

(Signature) Bertrand M. Lester Jr
310 Petroleum Building, Wichita, Kansas
(Address)

SUBSCRIBED AND SWORN to before me this 10th day of September, 19 65
Talia Zuhars
Notary Public.
My commission expires May 7, 1966.

WELL LOG
Sinclair A-1
C SW NW Section 28 T21S R25W
Hodgeman County, Kansas

<u>FROM</u>	<u>TO</u>		<u>Elevation</u>	<u>2431 RB</u>
0	273	Shale & Shells		
273	700	Shale & Shells	<u>Formation Tops</u>	
700	1050	Shale, Shells, & Red Bed		
1050	1055	Anhydrite		
1055	1400	Shale & Shells		
1400	1870	Shale, Shells & Red Bed	Heebner	3840
1870	2150	Shale W/Lime Streaks	Lansing	3890
2150	2270	Lime & Shale	BKC	4282
2270	2440	Shale & Lime	Fort Scott	4438
2440	2885	Lime	Cherokee	4462
2885	3925	Lime & Shale	Weathered Miss	4517
3925	4587	Lime	Miss	4532
4587		Total Depth		

RECEIVED
STATE CORPORATION COMMISSION

SEP 13 1965

CONSERVATION DIVISION
Wichita, Kansas

STATE OF KANSAS

COUNTY OF BARTON ss

T.D. Sweetman, Partner of S & S Drilling Company, Being first duly sworn on oath says: That I have knowledge of the facts, statements and matters herein contained and the log of the above described well as filed and that the same are true and correct.

T.D. Sweetman

Subscribed and sworn before me this 1st day of September, 1965.

[Signature]
Notary Public Barton County

My Commission Expires April 24, 1967