


STATE OF KANSAS
STATE CORPORATION COMMISSION

WELL PLUGGING RECORD

Give All Information Completely
Make Required Affidavit
Mail or Deliver Report to
Conservation Division
State Corporation Comm.
245 North Water
Wichita, KS 67202

Rice County, Sec. 19 Twp. 21 Rge. 7 E/W
Location as "NE/CNW 1/4 SW 1/4" or footage from lines
C NE NE
Lease Owner Sterling Drilling Co.
Lease Name Barber #1 Well No.
Office Address Sterling, Kansas 67579
Character of Well (Completed as Oil, Gas or Dry Hole)

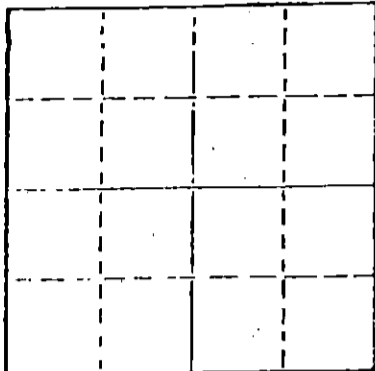

Locate well correctly on above
Section Plot

Date Well completed 19
Application for plugging filed 19
Application for plugging approved 19
Plugging commenced 1/30/80 19
Plugging completed 2/4/80 19
Reason for abandonment of well or producing formation
depleted.

If a producing well is abandoned, date of last production 19

Was permission obtained from the Conservation Division or
its agents before plugging was commenced? yes

Name of Conservation Agent who supervised plugging of this well ~~KK~~ Toman
Producing formation Depth to top Bottom Total Depth of Well 3403
Show depth and thickness of all water, oil and gas formations.

OIL, GAS OR WATER RECORDS

CASING RECORD

FORMATION	CONTENT	FROM	TO	SIZE	PUT IN	PULLED OUT
				8-5/8	176	none
				5 1/2"	3402	2823'

Describe in detail the manner in which the well was plugged, indicating where the mud fluid
was placed and the method or methods used in introducing it into the hold. If cement or other
plugs were used, state the character of same and depth placed, from _____ feet to
_____ feet for each plug set.

Sanded to 3550' and ran 5 sacks cement. Loaded hole, shot pipe at 2928', 2832',
pulled 89 joints. Set rock bridge at 330 to 315' and dumped 10 sacks cement. Ran
7 yards ready mix.

PLUGGING COMPLETE.

(If additional description is necessary, use BACK of this sheet)

Name of Plugging Contractor KELSO CASING PULLING
CHASE, KANSAS

STATE OF KANSAS COUNTY OF RICE, ss.
R. DARRELL KELSO (employee of owner) or (owner or operator)
of the above-described well, being first duly sworn on oath, says: That I have knowledge of
the facts, statements, and matters herein contained and the log of the above-described well
as filed and that the same are true and correct. So help me God.

(Signature) R. Darrell Kelso
CHASE, KANSAS
(Address)

SUBSCRIBED AND SWORN TO before me this 11th day of Feb., 19 80

My commission expires



Margaret Melcher
Notary Public.

RECEIVED
STATE CORPORATION COMMISSION
FEB 13 1980
CONSERVATION DIVISION
Wichita, Kansas

STERLING DRILLING COMPANY
P. O. Box 129
Sterling, Kansas 67579

WELL LOG ----- BARBER #1
Located: C NE NE, Sec. 19-21S-7W, Rice County, Kansas

OWNER: Sterling Drilling Company and Martin Oil and Gas Company
ROTARY DRILLING CONTRACTOR: Sterling Drilling Company

COMMENCED: June 13, 1972
COMPLETED: June 18, 1972

TOTAL DEPTH: 3403'

<u>LOG</u>	<u>CASING RECORD</u>
0 - 90 Sand and Clay	Ran 4 joints 8 5/8" new 20# casing (164.63) set at 176' K.B. with 160 sacks 60/40 Pozmix with HA5. Plug down at 2:30 PM, 6-13-72 by Howco.
90 - 197 Shale	
197 - 1090 Shale and Salt	
1090 - 3140 Lime and Shale	
3140 - 3332 Lime	
3332 - 3403 Shale and Lime and Chert	Ran 108 joints 5 1/2" 14# 8rd casing tested 4000#, 3409.99 threads off, set at 3402' with 75 cu. ft. salt saturated cement. Plug down 7:40 PM, 6-18-72.

RECEIVED
STATE CORPORATION COMMISSION
JAN 25 1983
CONSERVATION DIVISION
Wichita, Kansas