

STATE OF KANSAS
STATE CORPORATION COMMISSION


WELL PLUGGING RECORD

Give All Information Completely
Make Required Affidavit
Mail or Deliver Report to:
Conservation Division
State Corporation Commission
800 Bitting Building
Wichita, Kansas

Rice County. Sec. 19 Twp. 21 Rge. 7 W(E) (W)

Location as "NE/CNW/SW" or footage from lines SW SW SW
Lease Owner Buick Drilling Inc.
Lease Name Barber Well No. 1
Office Address 409 Wolcott Bldg., Hutchinson, Kansas
Character of Well (completed as Oil, Gas or Dry Hole) Dry Hole
Date well completed Feb. 13 1961
Application for plugging filed Feb. 13 1961
Application for plugging approved Feb. 13 (verbally) 1961
Plugging commenced Feb. 13 1961
Plugging completed Feb. 13 1961
Reason for abandonment of well or producing formation

NORTH

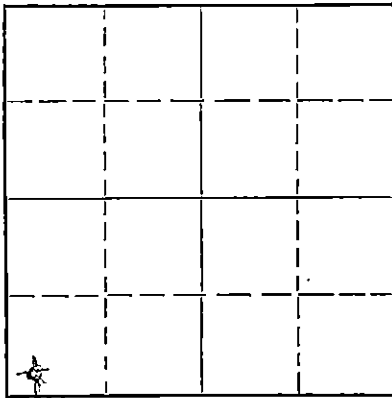

Locate well correctly on above
Section Plat

If a producing well is abandoned, date of last production 19
Was permission obtained from the Conservation Division or its agents before plugging was commenced? Yes

Name of Conservation Agent who supervised plugging of this well Gilbert Toman
Producing formation Depth to top Bottom Total Depth of Well 3145 Feet
Show depth and thickness of all water, oil and gas formations.

OIL, GAS OR WATER RECORDS

CASING RECORD

FORMATION	CONTENT	FROM	TO	SIZE	PUT IN	PULLED OUT
				8 5/8"	205'	None

Describe in detail the manner in which the well was plugged, indicating where the mud fluid was placed and the method or methods used in introducing it into the hole. If cement or other plugs were used, state the character of same and depth placed, from feet to feet for each plug set.

Hole filled with heavy rotary mud. Plug #1 set at 200' with 20 Sacks cement and 1/2 sack of Hulls on top; Plug #2 at 35' with 10 Sacks of cement and 1/2 Sack of Hulls on top. 2 Sacks cement in rat hole

RECEIVED
STATE CORPORATION COMMISSION
WICHITA, KANSAS
2-16-1961

(If additional description is necessary, use BACK of this sheet)
Name of Plugging Contractor Buick Drilling Inc.
Address 409 Wolcott Bldg. Hutchinson, Kansas

STATE OF Kansas, COUNTY OF Reno, ss.
H. R. Buick - President & owner (employee of owner) or (owner or operator) of the above-described well, being first duly sworn on oath, says: That I have knowledge of the facts, statements, and matters herein contained and the log of the above-described well as filed and that the same are true and correct. So help me God.

(Signature) H. R. Buick
(Address)

SUBSCRIBED AND SWORN TO before me this 13th day of February, 1961

My commission expires Nov. 16, 1961
Wilma A. Clark Notary Public.

W E L L L O G

HARBOR #1 SW SW SW Sec. 19-21S-7W
 Rice County, Kansas
 OWNER Buick Drilling Inc. et al
 CONTRACTOR Buick Drilling Inc.
 COMMENCED Feb. 2, 1961
 COMPLETED Feb. 13, 1961
 CASING 205' of 8 5/8", cemented
 with 140 Sacks
 ELEVATION 1620' Derrick Floor

DEPTH	FORMATION
0 - 90	Sand
90 - 190	Red Bed
190 - 206	Red Bed and Lime Shells
206 - 380	Shale
380 - 850	Shale and Shells
850 - 1075	Salt
1075 - 1220	Shale and Lime
1220 - 1640	Lime with Shale Streaks
1640 - 2045	Lime and Shale
2045 - 2115	Shale
2115 - 2500	Lime and Shale
2500 - 2848	Lime
2848 - 2954	Lime and Shale
2954 - 3012	Lime
3012 - 3065	Lime and Shale Streaks
3065 - 3275	Lime
3275 - 3348	Lime and Shale Streaks
3348 - 3375	Lime and Shale
3375 - 3384	Conglomerate
3384 - 3445	Chert - Mississippian
Total Depth	
Dry and Abandoned	

I, H. R. Buick, certify that this is a true and correct copy of the Log of the above well, according to the records of this office.

H. R. Buick Pres.
Buick Drilling Inc.

Subscribed and sworn to before me, a Notary Public, this 15th day of February, 1961.

Wilma A. Clark
Wilma A. Clark Notary Public

My Commission Expires Nov. 15, 1961

RECEIVED
STATE CORPORATION COMMISSION

MAR 6 1961

CONSERVATION DIVISION
Wichita, Kansas