


STATE OF KANSAS  
 STATE CORPORATION COMMISSION  
 CONSERVATION DIVISION  
 P. O. BOX 17027  
 WICHITA, KANSAS 67217

FORM CP-4

WELL PLUGGING RECORD

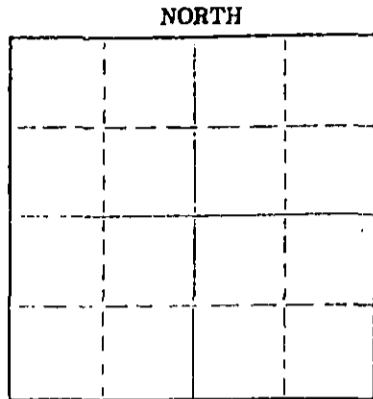

Locate well correctly on above Section Plot

Rice County. Sec. 19 Twp. 21 Rge. 7 (E) (W)  
 Location as "NE/CNW&SW" or footage from lines. W/2 SE SW  
 Lease Owner Sterling Drilling Company  
 Lease Name Barber #1A Well No. \_\_\_\_\_  
 Office Address Sterling, Kansas 67579  
 Character of Well (completed as Oil, Gas or Dry Hole) \_\_\_\_\_  
 Date well completed \_\_\_\_\_ 19\_\_\_\_  
 Application for plugging filed \_\_\_\_\_ 19\_\_\_\_  
 Application for plugging approved \_\_\_\_\_ 19\_\_\_\_  
 Plugging commenced 4/24/75 \_\_\_\_\_ 19\_\_\_\_  
 Plugging completed 4/26/75 \_\_\_\_\_ 19\_\_\_\_  
 Reason for abandonment of well or producing formation depleted.  
 If a producing well is abandoned, date of last production \_\_\_\_\_ 19\_\_\_\_  
 Was permission obtained from the Conservation Division or its agents before plugging was commenced? yes

Name of Conservation Agent who supervised plugging of this well Toman  
 Producing formation \_\_\_\_\_ Depth to top \_\_\_\_\_ Bottom \_\_\_\_\_ Total Depth of Well 3436 Feet  
 Show depth and thickness of all water, oil and gas formations.

OIL, GAS OR WATER RECORDS

CASING RECORD

FORMATION	CONTENT	FROM	TO	SIZE	PUT IN	PULLED OUT
				8-5/8	170	none
				5 1/8"	3420	2808'

Describe in detail the manner in which the well was plugged, indicating where the mud fluid was placed and the method or methods used in introducing it into the hole. If cement or other plugs were used, state the character of same and depth placed, from \_\_\_\_\_ feet to \_\_\_\_\_ feet for each plug set.

Checked hole to 3436', ran sand to 3400' and ran 5 ~~sacks~~ sacks of cement. Loaded hole, shot pipe at 2812', pulled 88 joints. Pumped 3 sacks hulls, 20 sacks gel and ~~30~~ 85 sacks cement. 5-8-1975

RECEIVED  
 STATE CORPORATION COMMISSION

PLUGGING COMPLETE.

MAY 0 1975

CONSERVATION DIVISION  
 Wichita, Kansas

Name of Plugging Contractor KELSO CASING PULLING  
 Address CHASE, KANSAS

STATE OF KANSAS COUNTY OF RICE  
R. DARRELL KELSO ss.

(employee of owner) or (owner or operator) of the above-described well, being first duly sworn on oath, says: That I have knowledge of the facts, statements, and matters herein contained and the log of the above-described well as filed and that the same are true and correct. So help me God.

(Signature) R. Darrell Kelso  
CHASE, KANSAS  
 (Address)

Subscribed and Sworn to before me this 29th day of April 19 75

My commission expires \_\_\_\_\_  
 NOTARY PUBLIC  
**MARGARET MELCHER**  
 Rice County, Ks.  
 My Comm. Exp. Feb. 15, 1979

Margaret Melcher  
 Notary Public.

STERLING DRILLING COMPANY  
P. O. Box 129  
Sterling, Kansas 67579

WELL LOG - - - - - BARBER "A" #1  
Located: W/2 SE/4 SW/4, Section 19-21E-7W, Rice County, Kansas

Owner: Sterling Drilling Company, et al  
Rotary Drilling Contractor: Sterling Drilling Company

COMMENCED: July 16, 1974  
COMPLETED: July 22, 1974

TOTAL DEPTH: 3422'

<u>LOG</u>	<u>CASING RECORD</u>
0 - 80 Sand	Ran 4 joints 8 5/8" 20# new seamless casing, 159.38' pipe set at 170.38 KB. Cemented with 175 sacks 60/40 Pozmix with 3% cc. Plug down at 1:00 AM, 7-17-74.
80 - 172 Shale	
172 - 905 Shale and Salt	
905 - 1150 Shale and Shells	
1150 - 1395 Shale and Lime Shells	
1395 - 1563 Shale	
1563 - 2400 Shale and Lime	
2400 - 2610 Shale	
2610 - 3422 Lime and Shale	Ran 75 joints used and 33 joints new 5 1/2" 14# casing (108 total joints), 3425.31' pipe set at 3421.5' K.B. Cemented with 100 sacks salt saturated Pozmix #1. Plug down at 2:45 PM, 7-22-74.

RECEIVED  
STATE CORPORATION COMMISSION  
MAY 8 1975  
CONSERVATION DIVISION  
Wichita, Kansas