


STATE OF KANSAS  
 STATE CORPORATION COMMISSION  
 CONSERVATION DIVISION  
 P. O. BOX 17027  
 WICHITA, KANSAS 67217

FORM CP-4

WELL PLUGGING RECORD

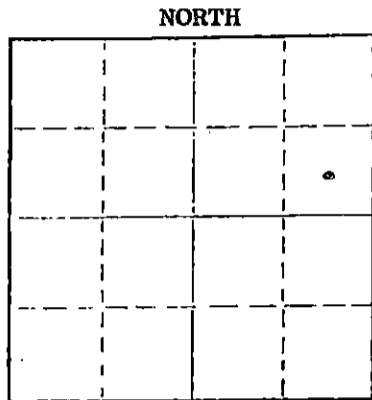

Locate well correctly on above Section Plat

Rice County, Sec. 18 Twp. 21 Rge. (E) 7 (W)  
 Location as "NE/CNW4SW4" or footage from lines C SE NE  
 Lease Owner Isern Petroleum Company  
 Lease Name McCrory Well No. 3  
 Office Address Box 486, Ellinwood, Kansas 67526  
 Character of Well (completed as Oil, Gas or Dry Hole) oil  
 Date well completed Aug. 2 1971  
 Application for plugging filed Jan. 6 1975  
 Application for plugging approved 1975  
 Plugging commenced Feb. 3 1975  
 Plugging completed Feb. 11 1975  
 Reason for abandonment of well or producing formation depleted

If a producing well is abandoned, date of last production 19  
 Was permission obtained from the Conservation Division or its agents before plugging was commenced? yes

Name of Conservation Agent who supervised plugging of this well Gilbert Toman  
 Producing formation \_\_\_\_\_ Depth to top \_\_\_\_\_ Bottom \_\_\_\_\_ Total Depth of Well 3360 Feet  
 Show depth and thickness of all water, oil and gas formations.

OIL, GAS OR WATER RECORDS				CASING RECORD		
FORMATION	CONTENT	FROM	TO	SIZE	PUT IN	PULLED OUT
			190'	8 5/8"	190'	none
			3359'	5 1/2"	3359'	2942.26

Describe in detail the manner in which the well was plugged, indicating where the mud fluid was placed and the method or methods used in introducing it into the hole. If cement or other plugs were used, state the character of same and depth placed, from \_\_\_\_\_ feet to \_\_\_\_\_ feet for each plug set.

Sanded back to 3300' and dumped 5 sacks of cement.  
 Set 10' rock bridge at 220' and plugged well with 35 sacks of cement.

Name of Plugging Contractor PIPE PULLERS, INC. (If additional description is necessary, use BACK of this sheet)  
 Address Box 128, Ellinwood, Kansas 67526

STATE OF KANSAS COUNTY OF BARTON SS.  
 Evelyn Roth (employee of owner) or (owner or operator) of the above-described well, being first duly sworn on oath, says: That I have knowledge of the facts, statements, and matters herein contained and the log of the above-described well as filed and that the same are true and correct. So help me God.

(Signature) Evelyn Roth  
 Ellinwood, Kansas (Address)

Subscribed and Sworn to before me this 11th day of February 1975

My commission expires  
 JENNY KASSELMAN  
 NOTARY PUBLIC  
 BARTON COUNTY, KANSAS  
 MY COMM. EXP. JULY 16, 1978

Jenny Kasselmann Notary Public.

RECEIVED  
 STATE CORPORATION COMMISSION  
 FEB 13 1975  
 CONSERVATION DIVISION  
 Wichita, Kansas  
 2-13-75

GABBERT-JONES, INC.  
 WICHITA, KANSAS  
 DRILLERS' WELL LOG

MCCRORY #3  
 C SE NE Sec. 18-21S-7W  
 Rice County, Kansas

Commenced: July 26, 1971  
 Completed: August 2, 1971

OPERATOR: ISERN WELLS

DEPTH		FORMATION	REMARKS
From	To		
0	85	Sand	Ran 4 joints of new 20# 8 5/8" casing
85	190	Redbed	set @ 190' w/175 sks sunset
190	1025	Shale	2% Gel
1025	1508	Shale and Lime	P.D. 7:30 PM 7/26/71
1508	1825	Lime and Shale	Job by Sun
1825	2245	Shale	Cement Cir.
2245	2595	Shale and Lime	
2595	2907	Lime and Shale	
2907	2975	Lime	
2975	3100	Lime and Shale	
3100	3245	Lime	
3245	3332	Lime and Shale	
3332	3355	Lime-Shale and Chert	
3355	3360	Lime	Ran 103 joints used 5 1/2" casing
3360	TD		14# set @ 3359' w/75 sks Salt Sat. Common. P.D. 9:30 PM 8/2/1971 Job by Sun


I, James S. Sutton II, certify this is a correct copy of the Drillers' Log for the well drilled in the C SE NE, Section 18-21S-7W, Rice County, Kansas, to the best of my knowledge and belief.

  
 James S. Sutton II

STATE OF KANSAS )  
 ) SS  
 COUNTY OF SEDGWICK )

Before me, the undersigned, a Notary Public within and for said County and State on this 4th day of August 1971, personally appeared James S. Sutton II to me personally known to be the identical person who executed the within and foregoing instrument and acknowledged to me that he executed the same as his free and voluntary act and deed for the uses and purposes therein set forth.

IN WITNESS WHEREOF, I have hereunto set my hand and official seal the day and year last above written.

  
 Marjorie Hall

My commission expires Nov. 29, 1971

RECEIVED  
 STATE CORPORATION COMMISSION  
 JAN 7 1975  
 CONSERVATION DIVISION  
 Wichita, Kansas