


STATE OF KANSAS
STATE CORPORATION COMMISSION

WELL PLUGGING RECORD
OR
FORMATION PLUGGING RECORD

Give All Information Completely
Make Required Affidavit
Mail or Deliver Report to:
Conservation Division
State Corporation Commission
800 Biting Building
Wichita, Kansas

Strike out upper line
when reporting plug-
ging off formations.

NORTH

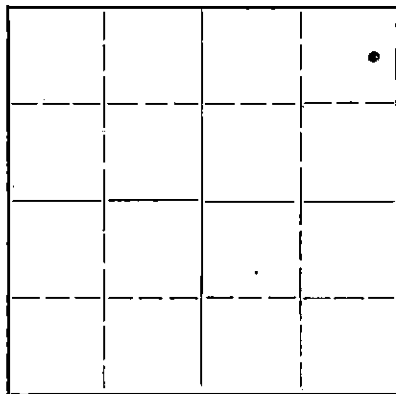

Locate well correctly on above
Section Plat

Rice County, Sec. 7 Twp. 21S Rge. 7W (E) (W)

Location as "NE1/4NW1/4SW1/4" or footage from lines NE-E2-NE

Lease Owner The Atlantic Refining Company

Lease Name Patton B Well No. 2

Office Address P.O. Box 17- Great Bend, Kansas

Character of Well (completed as Oil, Gas or Dry Hole) Oil

Date well completed March 3, 1937

Application for plugging filed April 16, 1942

Application for plugging approved April 17, 1942

Plugging commenced July 21, 1942

Plugging completed July 28, 1942

Reason for abandonment of well or producing formation Production declined
below 1 barrel of oil per day

If a producing well is abandoned, date of last production May 1, 1942

Was permission obtained from the Conservation Division or its agents before plugging was com-
menced? Yes

Name of Conservation Agent who supervised plugging of this well Mr. Ruel Durkee

Producing formation Conglomerate Depth to top 3315' Bottom 3333' Total Depth of Well 3333' Feet

Show depth and thickness of all water, oil and gas formations.

OIL, GAS OR WATER RECORDS

CASING RECORD

Formation	Content	From	To	Size	Put In	Pulled Out
Sand	Water	0	72	10 3/4"	100'	None
Conglomerate	Oil	3315'	3333'	7" OD	3330'	2300'

Describe in detail the manner in which the well was plugged, indicating where the mud fluid was placed and the method or methods used in introducing it into the hold. If cement or other plugs were used, state the character of same and depth placed, from.....feet to.....feet for each plug set.

3328' to 3333' Filled up with chat
3300' to 3328' Cement Plug (6 sacks of cement)
160' to 3300' Filled with heavy drilling mud and dirt
150' to 160' Crushed rock bridge
120' to 150' Cement Plug (15 sacks of cement)
Filled up from 120' to within 8' of top of surface pipe with dirt and chat
Filled up the 8' of surface casing with cement and capped the base of the
cellar with cement (used 5 sacks of cement)

8-15-1942

DI PLUGGING
FILE 7 21-2W
31 23

AUG 15 1942

(If additional description is necessary, use BACK of this sheet)

Correspondence regarding this well should be addressed to Mr. S.K. Myers
Address P.O. Box 17- Great Bend, Kansas

STATE OF ~~KANSAS~~ Kansas, COUNTY OF Barton, ss.
Mr. Stanton K. Myers (employee of owner) or (owner or operator) of the above-described well,

being first duly sworn on oath, says: That I have knowledge of the facts, statements, and matters herein contained and the log of the above-described well as filed and that the same are true and correct. So help me God.

(Signature) Stanton K. Myers, Supt.

P.O. Box 17, Great Bend, Kansas (Address)

SUBSCRIBED AND SWORN to before me this 17th day of August, 1942

My commission expires Oct. 28, 1944

H.C. Colquhoun, Notary Public