


STATE OF KANSAS
STATE CORPORATION COMMISSION

Form CP-4

WELL PLUGGING RECORD

Give All Information Completely
Make Required Affidavit
Mail or Deliver Report to:
Conservation Division
State Corporation Commission
P. O. Box 17027

Wichita, Kansas 67217
NORTH

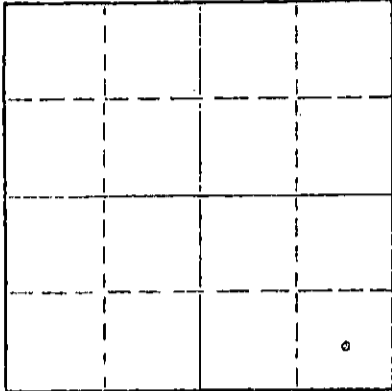

Locate well correctly on above
Section Plat

Rice County, Sec. 7 Twp. 21 Rge. (E) 7 (W)
Location as "NE/CNW/SE" or footage from lines. Approx. SE SE
Lease Owner Aspen Drilling Company
Lease Name Heter Well No. 1
Office Address Box 783, Great Bend, Kansas 67530
Character of Well (completed as Oil, Gas or Dry Hole) oil
Date well completed 19
Application for plugging filed January 13 19 72
Application for plugging approved 19
Plugging commenced February 16 19 72
Plugging completed February 17 19 72
Reason for abandonment of well or producing formation depleted

If a producing well is abandoned, date of last production 19
Was permission obtained from the Conservation Division or its agents before plugging was commenced? yes

Name of Conservation Agent who supervised plugging of this well Gilbert Toman
Producing formation Depth to top Bottom Total Depth of Well 3375 Feet
Show depth and thickness of all water, oil and gas formations.

OIL, GAS OR WATER RECORDS

CASING RECORD

FORMATION	CONTENT	FROM	TO	SIZE	PUT IN	PULLED OUT
		0	161'	8 5/8"	161'	none
		0	3374'	5 1/2"	3374'	2868.87

Describe in detail the manner in which the well was plugged, indicating where the mud fluid was placed and the method or methods used in introducing it into the hole. If cement or other plugs were used, state the character of same and depth placed, from feet to feet for each plug set.

Sanded back to 3300' and dumped 5 sacks of cement.

Set 15' rock bridge at 215'. Plugged well with 3 1/2 yards of ready mix cement.

RECEIVED
STATE CORPORATION COMMISSION
FEB 24 1972
CONSERVATION DIVISION
Wichita, Kansas

Name of Plugging Contractor PIPE PULLERS, INC.
Address Box 486, Ellinwood, Kansas 67526

STATE OF KANSAS COUNTY OF BARTON, SS.

Evelyn Roth (employee of owner) or (owner or operator) of the above-described well, being first duly sworn on oath, says: That I have knowledge of the facts, statements, and matters herein contained and the log of the above-described well as filed and that the same are true and correct. So help me God.

(Signature) Evelyn Roth
Ellinwood, Kansas (Address)

SUBSCRIBED AND SWORN TO before me this 23 day of February, 19 72

My commission expires Feb. 10, 1975

George A. Meyer
Notary Public.

15-159-20389-0000

R

RECEIVED
STATE CORPORATION COMMISSION

JAN 17 1972
CONSERVATION DIVISION
Wichita, Kansas

STERLING DRILLING COMPANY
P. O. Box 129
Sterling, Kansas 67579

WELL LOG ----- HETER #1
Located: Appr. SE SE, Section 7-21S-7W, Rice County, Kansas

OWNER: Aspen Drilling Company
ROTARY DRILLING CONTRACTOR: Sterling Drilling Company

COMMENCED: August 30, 1971
COMPLETED: September 4, 1971

TOTAL DEPTH: 3375'

<u>LOG</u>	<u>CASING RECORD</u>
0 - 65 Sand	Ran 4 joints 8 5/8", 161.62' cemented at 173 K.B. with 160 sacks quik-set 2% gel. Plug down at 7:00 PM, 8-30-71.
65 - 175 Sand and Red Bed	
175 - 480 Shale and Red Bed	
480 - 1255 Shale and Lime - Salt	Ran 110 joints 5 1/2" OD casing, 3360' cemented at 3374' K.B. with 75 sacks salt saturated cement with mud flush. Plug down.
1255 - 2820 Shale and Lime	
2820 - 3375 Lime	