


WELL PLUGGING RECORD

Give All Information Completely
Make Required Affidavit
Mail or Deliver Report to:
Conservation Division
State Corporation Commission
211 No. Broadway
Wichita, Kansas

NORTH

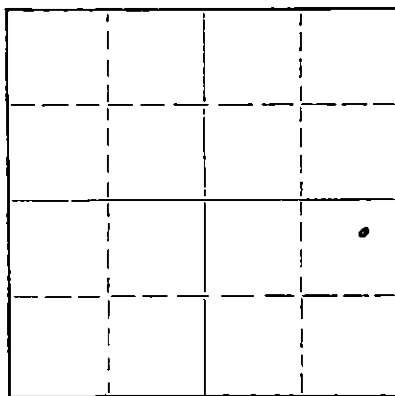

Locate well correctly on above
Section Plat

McPherson County. Sec. 32 Twp. 21 S. Rge. 3 XX (W)
Location as "NE/CNW/SW" or footage from lines 912' F N L-865' F E L of SE 1/4
Lease Owner Kewanee Oil Company
Lease Name Delmer Well No. 1
Office Address Box 589, El Dorado, Kansas
Character of Well (completed as Oil, Gas or Dry Hole) oil
Date well completed 9-21 19 54
Application for plugging filed 7-13 19 59
Application for plugging approved 7-13 19 59
Plugging commenced 7-13 8:00 A M 19 59
Plugging completed 7-16 7:00 P. M. 19 59
Reason for abandonment of well or producing formation stopped producing

If a producing well is abandoned, date of last production 5-21 19 59

Was permission obtained from the Conservation Division or its agents before plugging was commenced? yes

Name of Conservation Agent who supervised plugging of this well Lee Guthrie
Producing formation Miss. chat Depth to top 3139 Bottom 3153 Total Depth of Well 3690 Feet
Show depth and thickness of all water, oil and gas formations. plug back

OIL, GAS OR WATER RECORDS

CASING RECORD

FORMATION	CONTENT	FROM	TO	SIZE	PUT IN	PULLED OUT
				10 3/4	327'	circulated
				7"	3630	2040

Describe in detail the manner in which the well was plugged, indicating where the mud fluid was placed and the method or methods used in introducing it into the hole. If cement or other plugs were used, state the character of same and depth placed, from _____ feet to _____ feet for each plug set.

25 sacks cement dumped at 3215', fill up 137' dumped with bailer
327' 10' rock bridge, 15 sacks cement dumped dry
Mudded to 35'
35' * 15' rock bridge, 10 sacks cement dumped dry

Cap welded on surface casing

RECEIVED
STATE CORPORATION COMMISSION
JUL 22 1959
CONSERVATION DIVISION
Wichita, Kansas

(If additional description is necessary, use BACK of this sheet)

Name of Plugging Contractor Kent Well Servicing Company
Address Box 667, El Dorado, Kansas

STATE OF Kansas, COUNTY OF Butler, ss.
B.C. JACKSON (employee of owner) or (owner or operator) of the above-described well, being first duly sworn on oath, says: That I have knowledge of the facts, statements, and matters herein contained and the log of the above-described well as filed and that the same are true and correct. So help me God.

(Signature) B. C. Jackson
Box 589, El Dorado, Kansas (Address)

SUBSCRIBED AND SWORN TO before me this 21 day of July 19 59

My commission expires 11-28-60 Saverly M. Pringle Notary Public.

PLUGGING
FILE SEC 32 T. 21. R. 3 W.
BOOK PAGE 53 LINE 12