

STATE OF KANSAS
STATE CORPORATION COMMISSION


Give All Information Completely
Make Required Affidavit
Mail or Deliver Report to:
Conservation Division
State Corporation Commission
211 No. Broadway
Wichita, Kansas

WELL PLUGGING RECORD

McPherson County, Sec. 32 Twp. 21 Rge. 3 (E) (W) X

Location as "NE/CNW%SW%" or footage from lines SE/4 SW/4 SE/4
Lease Owner Brunson-Spines
Lease Name Schroeder Well No. 5
Office Address 800 Wichita Plaza, Wichita, Kansas 67202
Character of Well (completed as Oil, Gas or Dry Hole) Dry
Date well completed November 26, 1965
Application for plugging filed 19
Application for plugging approved 19
Plugging commenced 19
Plugging completed November 26, 1965
Reason for abandonment of well or producing formation Dry

NORTH

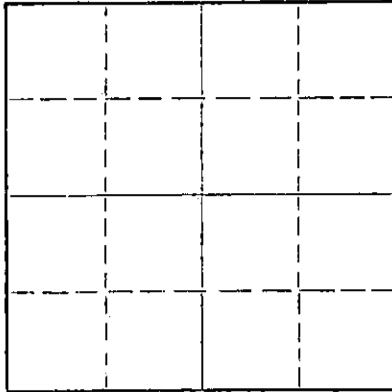

Locate well correctly on above
Section Plat

If a producing well is abandoned, date of last production 19
Was permission obtained from the Conservation Division or its agents before plugging was commenced? Yes

Name of Conservation Agent who supervised plugging of this well Gilbert J. Toman, Holyrood, Kansas
Producing formation _____ Depth to top _____ Bottom _____ Total Depth of Well _____ Feet
Show depth and thickness of all water, oil and gas formations.

OIL, GAS OR WATER RECORDS

CASING RECORD

FORMATION	CONTENT	FROM	TO	SIZE	PUT IN	PULLED OUT
Clay		0	30	13 in.		
Sand		30	200	13 in.		
Shale		200	245	13 in.	245 ft.	None

Describe in detail the manner in which the well was plugged, indicating where the mud fluid was placed and the method or methods used in introducing it into the hole. If cement or other plugs were used, state the character of same and depth placed, from _____ feet to _____ feet for each plug set.

Set bridge at 240 ft. and cemented with 30 sacks cement, filled hole to 30 ft. and set plug with 15 sacks cement, 2 sacks in rathole. Plug down at 7:00 P.M., November 26, 1965.

RECEIVED
STATE CORPORATION COMMISSION

DEC - 2 1965

CONSERVATION DIVISION
Wichita, Kansas

(If additional description is necessary, use BACK of this sheet)
Name of Plugging Contractor Blackstone Drilling, Inc.
Address Box # 455, McPherson, Kansas 67460

STATE OF Kansas, COUNTY OF McPherson, ss.
W. S. Bill Brunson (owner/operator) of the above-described well, being first duly sworn on oath, says: That I have knowledge of the facts, statements, and matters herein contained and the log of the above-described well as filed and that the same are true and correct. So help me God.

(Signature) W. S. Brunson
800 Wichita Plaza, Wichita, Kansas 67202
(Address)

SUBSCRIBED AND SWORN TO before me this 1st day of December, 1965

Pearl E. Craytor
Pearl E. Craytor
Notary Public.

My commission expires June 9, 1969



Blackstone Drilling, Inc.

Box 455 • 523 West Kansas • Phone CH 1-1250

McPHERSON • KANSAS
67460

November 29, 1965

COMPANY: BRUNSON-SPINES
 CONTRACTOR: BLACKSTONE DRILLING, INC.
 FARM: SCHROEDER # 5
 LOCATION: SE/4 SW/4 SE/4, Sec. 32-21-3W,
 McPherson County, Kansas
 COMMENCED: November 18, 1965
 COMPLETED: November 26, 1965
 ELEVATION:

0	to	30	Clay
30	to	200	Sand
200	to	245	Shale
245	to	775	Shale & Lime
775	to	2025	Lime & Shale
2025	to	2805	Lime
2805	to	2830	Shale & Lime
2830	to	3030	Lime & Shale
3030	to	3142	Shale & Lime
3142	to	3917	Mississippi
3917	to	3928	Lime
3928	to	3980	Kinderhook Shale
3980	to	3600	Shale & Lime
3600	to	3605	Viola
		3605	T. D.

RECEIVED
STATE CORPORATION COMMISSION

DEC -2 1965

CORPORATION DIVISION
Topeka, Kansas

Cut 17 1/4 in. hole to 245 ft. and run 248.05 ft. of 13 in. casing and cemented with 275 sacks cement on bottom at 245 ft. Plug down at 3:00 P.M., November 19, 1965. Used 3% Calcium Chloride. Cut 7 7/8 in. hole to 3605 ft. Hole Dry and abandoned. Set bridge at 240 ft. and cemented with 30 sacks cement, filled hole to 30 ft. and set plug with 15 sacks cement. 2 sacks in rathole. Plug down at 7:00 P.M., November 26, 1965. Plugging completed by state plugger, Gilbert J. Toman, Holyrood, Kansas.

TOPS: Mississippi - 3142' Kinderhook - 3928' Misner Sand - 3460'
 Maquoketa - 3462' Viola - 3590'

Measurements taken from K. B.

CERTIFICATE

I, H. J. Plouffe, President of Blackstone Drilling, Inc. do hereby certify that the above and foregoing is a true and correct copy of log on your Schroeder #5, located on the SE/4 SW/4 SE/4 of Sec. 32-21-3W, McPherson County, Kansas as reflected by the files of Blackstone Drilling, Inc.

H. J. Plouffe
 H. J. Plouffe - President

Subscribed and sworn to before me a Notary Public in and for McPherson County, Kansas this 29th day of November, 1965.

Ruth McVay
 Ruth McVay - Notary Public

My Commission Expires: December 18, 1965.