


WELL PLUGGING RECORD

Give All Information Completely
Make Required Affidavit
Mail or Delivery Report to:
Conservation Division
State Corporation Commission
800 Bittling Building
Wichita, Kansas

NORTH

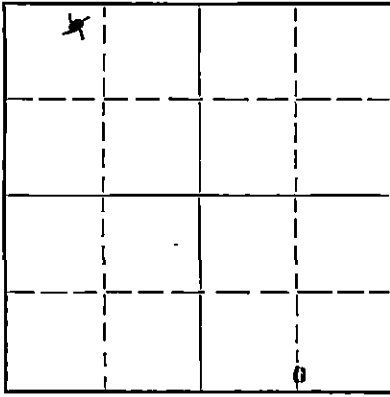

Locate well correctly on above
Section Plat

McPherson County. Sec. 15 Twp. 21 Rge. - (E) 3 (W)
Location as "NE/CNW $\frac{1}{4}$ SW $\frac{1}{4}$ " or footage from lines 30' W of C, NE NW NW
Lease Owner E. K. Carey & et al
Lease Name Neufeldt Well No. 1
Office Address Box 620, McPherson, Kansas
Character of Well (completed as Oil, Gas or Dry Hole) Dry hole
Date well completed January 3, 19 52
Application for plugging filed January 2, 19 52
Application for plugging approved January 2, 19 52
Plugging commenced January 3, 19 52
Plugging completed January 3, 19 52
Reason for abandonment of well or producing formation Dry hole

If a producing well is abandoned, date of last production 19
Was permission obtained from the Conservation Division or its agents before plugging was commenced? Yes

Name of Conservation Agent who supervised plugging of this well Ruel Durkee
Producing formation None Depth to top Bottom Total Depth of Well 3115 Feet
Show depth and thickness of all water, oil and gas formations.

OIL, GAS OR WATER RECORDS

CASING RECORD

Formation	Content	From	To	Size	Put In	Pulled Out
				8-5/8	180'	None

Describe in detail the manner in which the well was plugged, indicating where the mud fluid was placed and the method or methods used in introducing it into the hole. If cement or other plugs were used, state the character of same and depth placed, from feet to feet for each plug set.

Circulated heavy mud on bottom. Gunned pits and circulated again at 1/2 way out with drill pipe. Filled with heavy mud to 240'. Shoved down wooden plug to 240', filled in rock to form solid bridge at this point. Ran 20 sacks cement through ~~drill pipe~~ drill pipe on bridge at 240', filled with heavy mud to 20' below cellar floor and then mixed and put in 5 sacks cement to cellar floor.

(If additional description is necessary, use BACK of this sheet)

Correspondence regarding this well should be addressed to E. K. Carey, Contractor
Address Box 620, McPherson, Kansas

STATE OF Kansas, COUNTY OF McPherson, ss.
Elmer Rider (employee of owner) or (owner or operator) of the above-described well,
being first duly sworn on oath, says: That I have knowledge of the facts, statements, and matters herein contained and the log of the above-described well as filed and that the same are true and correct. So help me God.

(Signature) *Elmer Rider*
Box 620, McPherson, Kansas
(Address)

SUBSCRIBED AND SWORN to before me this 4 day of January, 19 52

My commission expires November 13, 1952

23-5091-5

8-50-10M

RECEIVED
STATE CORPORATION COMMISSION

Notary Public.

FILE DEC 15 1952
BOOK PAGE 135

JAN - 7 1952
CONSERVATION DIVISION
Wichita, Kansas

ROTARY DRILLER'S LOG

15-113-01578-0000

E. K. Carey, Contractor et al
Box 620
McPherson, Kansas

Elevation: 1448 K. B.
1448 Gr. h.

Neufeldt #1
30' w of C.
NE NW NW
Sec. 15-21-3W
McPherson County, Kansas.

Casing Record:

8-5/8" 176.60' w/125 sx.

Well Commenced: 12-18-51
Well Completed: 1-3-52

Contractor: E. K. Carey, Contractor (Rig #1) Box 620, McPherson, Kansas
Geologist: Don Hollar, E. K. Carey Drlg. Co. 815 Central Bldg. Wichita

Figures Indicate Bottom of Formation K. B.

Base cellar & R. B.	8
Clay	22
Sand	120
Shale	150
Lime & shale	180
Shale & shells	345
Lime & shale	560
Shale & red bed	610
Lime & shale	915
Shale & lime	1560
Lime & shale	1585
Shale & lime	1800
Lime & shale	1960
Lime	2150
Sandy lime	2235
Lime & shale	2385
Lime	2680
Lime & shale	3007
Lime	3110
Shale	3115

Geologist Tops

Mississippi	3010	(-1562)
Kinderhook	3110	(-1662)
Rotary T. D.	3115	D & A

D. S. T. - 3021-3050 w/29' anchor,
open 1 hour, recovered 90' gas and
90' Sl. gas cut mud. BHP 250# 20 Min

D. S. T. - 3049-3095 w/46' anchor,
open 60 min. gas surfaced in 59 min.
recovered 150' oil and gas cut mud.
BHP 320# 15 Min

The above Rotary Driller's Log is complete and correct to the best of my knowledge.

E. K. CAREY, CONTRACTOR

Herbert Rhoton

By Herbert Rhoton, Superintendent

FILE SEC 15-21-3W
BOOK PAGE 135 LINE 83

RECEIVED
KANSAS COMMISSION