


STATE OF KANSAS  
STATE CORPORATION COMMISSION

Give All Information Completely  
Make Required Affidavit  
Mail or Deliver Report to:  
Conservation Division  
State Corporation Commission  
2 No. Market  
Wichita, Kansas

WELL PLUGGING RECORD

McPherson County, Sec. 15 Twp. 21 Rge. 3 (E) W (W)  
SW/4 SW/4

Location as "NE/CNW/SW" or footage from lines  
Lease Owner Donald T. Ingling et al  
Lease Name Kaufman Well No. 2  
Office Address Wichita, Kans.  
Character of Well (completed as Oil, Gas or Dry Hole) Oil  
Date well completed 12/22/66  
Application for plugging filed March 5 19 70  
Application for plugging approved March 6 19 70  
Plugging commenced Mar. 20 19 70  
Plugging completed Mar. 21 19 70  
Reason for abandonment of well or producing formation No Production

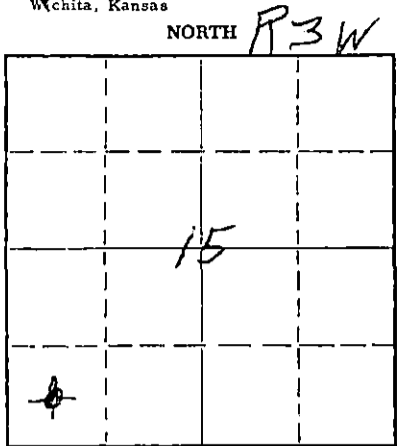

T  
21  
S

Locate well correctly on above  
Section Plat

If a producing well is abandoned, date of last production \_\_\_\_\_ 19 \_\_\_\_  
Was permission obtained from the Conservation Division or its agents before plugging was commenced? Yes

Name of Conservation Agent who supervised plugging of this well Hugh Scott  
Producing formation \_\_\_\_\_ Depth to top \_\_\_\_\_ Bottom \_\_\_\_\_ Total Depth of Well 3484 Feet  
Show depth and thickness of all water, oil and gas formations.

OIL, GAS OR WATER RECORDS

CASING RECORD

FORMATION	CONTENT	FROM	TO	SIZE	PUT IN	PULLED OUT
				8-5/8	216	none
				4-1/2	3484	2734

Describe in detail the manner in which the well was plugged, indicating where the mud fluid was placed and the method or methods used in introducing it into the hole. If cement or other plugs were used, state the character of same and depth placed, from \_\_\_\_\_ feet to \_\_\_\_\_ feet for each plug set.

Filled back with sand to 3400' and dumped 4 sacks of cement.  
Shot pipe off at 2734'. Pulled pipe and mudded hole to 240'.  
Set rock bridge from 240' to 220'. Finished filling hole with  
ready mix cement.

RECEIVED  
STATE CORPORATION COMMISSION  
MAY 18 1970  
CONSERVATION DIVISION  
Wichita, Kansas


Name of Plugging Contractor Bert Self (If additional description is necessary, use BACK of this sheet)  
Address Hutchinson, Kans.

STATE OF Kans. COUNTY OF Reno, ss.  
Employee (employee of owner) or (owner or operator) of the above-described well, being first duly sworn on oath, says: That I have knowledge of the facts, statements, and matters herein contained and the log of the above-described well as filed and that the same are true and correct. So help me God.

(Signature) Bert Self

R. R. #4, Hutchinson, Kans. 67501 (Address)

Subscribed and sworn to before me this 31st day of March, 19 70

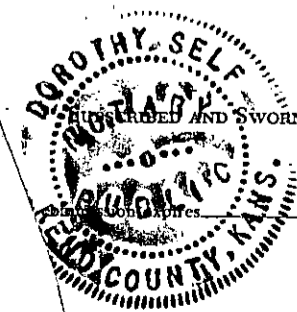

October 18, 1973

Notary Public.

15-113.30212-0000

WELL LOG - KAUFMAN NO. 2

Donald T. Ingling et al, Lease Owner

Section 15-21-3W

Donald T. Ingling, Contractor

Location: SW/4 SW/4

Commenced: 12-10-66

County: McPherson

Completed: 12-22-66

Production:

Total Depth: 3484' (rotary)

Elevation: 1452' RB

Casing: 8 5/8" 216' (140 sacks cement)  
4 1/2" 3484' (100 sacks cement)

Figures below indicate bottom formation

30	surface clay	3260	shale
120	sand and shale	3351	shale
261	shale and shells	3410	shale and lime streaks
395	shale and shells	3448	shale and Viola lime
500	shale and lime	3470	sand
513	shale	3484	sand
730	shale	3484	Total Depth
923	shale		
955	lime and shale		
1147	lime and shale		
1335	shale and shells		
1815	shale and lime		
1915	lime and shale		
2015	shale		
2185	lime and shale		
2420	shale and lime		
2470	lime		
2605	lime		
2690	lime		
2768	lime		
2840	shale and lime		
2955	shale and lime		
3055	shale		
3075	Mississippi chat		
3100	Mississippi		
3159	Mississippi lime		
3193	Mississippi lime		

RECEIVED  
STATE CORPORATION COMMISSION  
MAR 6 1970  
CONSERVATION DIVISION  
Wichita, Kansas

I certify this is a true and correct copy of the above mentioned well.

STATE OF KANSAS )  
                          ) ss.  
SEDGWICK COUNTY )

*[Signature]*

Subscribed and sworn to before me, a Notary Public, in said county and state.

*[Signature]*  
Notary Public

My commission expires: Feb. 27, 1968