

15.047.00282.00.00

STATE OF KANSAS  
STATE CORPORATION COMMISSION


Form CP-4

Give All Information Completely  
Make Required Affidavit  
Mail or Deliver Report to:  
Conservation Division  
State Corporation Commission  
211 No. Broadway  
Wichita, Kansas

WELL PLUGGING RECORD

Edwards County, Sec. 34 Twp. 23S Rge. 20 (E)      (W) West

NORTH

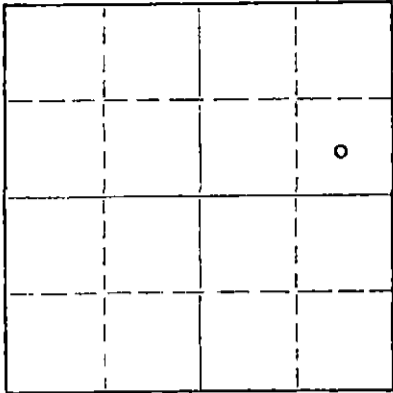

Locate well correctly on above Section Plat

Location as "NE/CNW/SW" or footage from lines c SE NE  
Lease Owner Kern-Landes Exploration Co. Inc.  
Lease Name Baier Well No. 1  
Office Address P. O. Box 699, Magnolia, Arkansas  
Character of Well (completed as Oil, Gas or Dry Hole) Dry Hole  
Date well completed May 27, 1963 19 63  
Application for plugging filed May 27, 19 63  
Application for plugging approved May 27, 19 63  
Plugging commenced May 27, 19 63  
Plugging completed May 27, 19 63  
Reason for abandonment of well or producing formation Dry Hole

If a producing well is abandoned, date of last production      19       
Was permission obtained from the Conservation Division or its agents before plugging was commenced? Yes

Name of Conservation Agent who supervised plugging of this well Archie Elving, Pratt, Kansas  
Producing formation      Depth to top      Bottom      Total Depth of Well      Feet  
Show depth and thickness of all water, oil and gas formations.

OIL, GAS OR WATER RECORDS

CASING RECORD

FORMATION	CONTENT	FROM	TO	SIZE	PUT IN	PULLED OUT
		0	274'	8 5/8"	274'	none

Describe in detail the manner in which the well was plugged, indicating where the mud fluid was placed and the method or methods used in introducing it into the hole. If cement or other plugs were used, state the character of same and depth placed, from      feet to      feet for each plug set.  
     20  
Set Plug @ 180' 200 sacks cement  
Plug @ 40' 10 sacks cement

RECEIVED  
STATE CORPORATION COMMISSION

JUN 7 1963

CONSERVATION DIVISION  
Wichita, Kansas

(If additional description is necessary, use BACK of this sheet)

Name of Plugging Contractor Hellar Drilling Company, Inc.  
Address 1014 Union Center, Wichita, Kansas

STATE OF Kansas, COUNTY OF Sedgwick, ss.  
D. L. Hellar, Pres. of Hellar Drlg. Co. Inc. (employee of owner) or (owner or operator) of the above-described well, being first duly sworn on oath, says: That I have knowledge of the facts, statements, and matters herein contained and the log of the above-described well as filed and that the same are true and correct. So help me God.

(Signature) D. L. Hellar D. L. Hellar, President  
1014 Union Center, Wichita 2, Kansas  
(Address)

SUBSCRIBED AND SWORN TO before me this 5th day of June, 19 63

My commission expires March 25, 1964.

Catherine Darcey  
Catherine Darcey -- Notary Public.

DRILLER'S LOG

COMPANY: Kern-Landes Exploration Co. Inc.  
 CONTRACTOR: Hellar Drilling Company, Inc.  
 LEASE: #1 Baier  
 LOCATION: c SE NE 34-23S-20W, Edwards County, Kansas  
 COMMENCED: May 10, 1963  
 COMPLETED: May 27, 1963  
 CASING: Set 8 5/8" surface casing @ 274'/200 sacks cement

0-274	Clay & Sand & Shale
274-785	Shale, Red Bed & Sand Streaks
785-1405	Shale & Shells & Red Bed & Sand
1405-1412	Red Bed & Shale
1412-1432	Anhydrite
1432-1785	Red Bed & Shale & Shells
1785-2116	Salt Section
2116-2365	Shale & Lime Streaks
2365-2460	Lime & Shale
2460-2530	Ft. Riley
2530-4025	Lime & Shale
4025-4057	Lime (Brown Lime 4031')
4057-4077	Lime - Lsg. K.C.
4077-4197	Lime & Shale
4197-4251	Lsg. K.C.
4251-4357	Lime
4357-4488	Lime & Shale
4488-4533	Reamed Core Hole (#1 Core 4488-4512)
4533-4605	Lime & Shale
4605-4618	Reamed Core Hole (#2 Core 4506-4618)
4618-4646	Mississippi Chert
4646-4686	Lime & Chert
4686-4743	Lime
4743	Rotary Total Depth - Ran Electric Log D & A

**RECEIVED**  
 STATE CORPORATION COMMISSION  
 JUN 7 1963  
 CONSERVATION DIVISION  
 Wichita, Kansas

STATE OF KANSAS )  
 ) SS  
 COUNTY OF SEDGWICK )

I, D. L. Hellar, do hereby certify that the above and foregoing is a true and correct copy of the log of the #1 Baier, located in c SE NE 34-23S-20W, Edwards County, Kansas, as reflected by the files of the Hellar Drilling Company, Inc.

HELLAR DRILLING COMPANY, INC.

By *D. L. Hellar*  
 President - D. L. Hellar

Subscribed and sworn to before me, a Notary Public, in and for Sedgwick County, Kansas, this 5th day of June, 1963.

My Commission Expires:  
 March 25, 1964.

*Catherine Darcy*  
 Notary Public - Catherine Darcy