15.159.05488.0000

STATE OF KANSAS
STATE CORPORATION COMMISSION

Give All Information Completely
Make Required Affidavit
Mail or Deliver Report to:
Conservation Division
State Corporation Commission
800 Bitting Building
Wichita, Kansas

WELL PLUGGING RECORD
OR
FORMATION PLUGGING RECORD

Strike out upper line when reporting plugging off formations.

NORTH

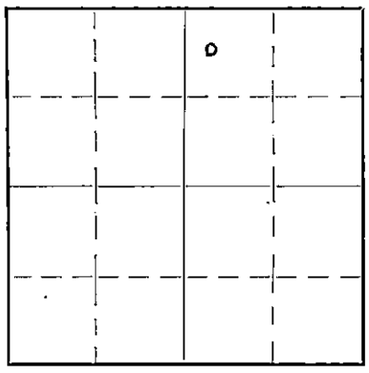

Locate well correctly on above Section Plat

Rice County. Sec. 23 Twp. 21 Rge. (E) 7 (W)

Location as "NE¼NW¼SW¼" or footage from lines Center of West 20 acres

Lease Owner: Garden & Spencer, Special

Lease Name: Jack Hauschild Well No. 1

Office Address: Hutchinson, Kansas

Character of Well (Completed as Oil, Gas or Dry Hole): Dry Hole

Date, well completed: August 15, 1940 193

Application for plugging filed: August 15, 1940 193

Application for plugging approved: August 12, 1940 193

Plugging Commenced: August 15, 1940 193

Plugging Completed: August 16, 1940 193

Reason for abandonment of well or producing formation: Dry Hole

If a producing well is abandoned, date of last production: None 193

Was permission obtained from the Conservation Division or its agents before plugging was commenced? Yes

Name of Conservation Agent who supervised plugging of this well: Ruel Durkee

Producing formation: None Depth to top: Bottom: Total Depth of Well: 3775 Feet.

Show depth and thickness of all water, oil and gas formations.

OIL, GAS OR WATER RECORDS — CASING RECORD

Formation	Content	From	To	Size	Put In	Pulled Out
				7 OD	3390 ft	2700 ft

Describe in detail the manner in which the well was plugged, indicating where the mud fluid was placed and the method or methods used in introducing it into the hole. If cement or other plugs were used, state the character of same and depth placed, from ..... feet to ..... feet for each plug set.

5 sax of cement on bridge at 3390, mud to 200 ft then bridged, 15 sax of cement used, then mud to 5 feet, then 5 sax of cement to bottom of cellar.

9-27-40

PLUGGING
FILE SEC. 23-21-7W
BOOK PAGE 112 LINE 40

Pd. 9/26/40 HA

(If additional description is necessary, use BACK of this sheet)

Correspondence regarding this well should be addressed to: Garden & Spencer

Address: Hutchinson, Kansas

STATE OF Kansas, COUNTY OF Reno, ss.

W. J. O'Connor - employee (employee of owner) or (owner or operator) of the above-described well, being first duly sworn on oath, says: That I have knowledge of the facts, statements, and matters herein contained and the log of the above-described well as filed and that the same are true and correct. So help me God.

(Signature) W J O'Connor

502 First National Bk Bldg - Hutchinson, Ks
(Address)

SUBSCRIBED AND SWORN TO before me this 23rd day of September, 19 40

Edmond Engel
Notary Public.

My commission expires: March 18, 1942

17-6058 10-38—5M