

STATE OF KANSAS
STATE CORPORATION COMMISSION


Form CP-4

WELL PLUGGING RECORD

Give All Information Completely
Make Required Affidavit
Mail or Deliver Report to:
Conservation Division
State Corporation Commission
212 No. Market
Wichita, Kansas

McPherson County. Sec. 3 Twp. 20 Rge. 2 (X) (W)
Location as "NE/CNW/SW" or footage from lines SE SE NE
Lease Owner George R. Hess
Lease Name Frank Unruh Well No. 3
Office Address 505 N. Charles McPherson, Kansas
Character of Well (completed as Oil, Gas or Dry Hole) Oil Well
Date well completed 12-3-65 19__
Application for plugging filed 7-19-66 19__
Application for plugging approved 7-21-66 19__
Plugging commenced 8-10-66 19__
Plugging completed 8-11-66 19__
Reason for abandonment of well or producing formation depleted

NORTH

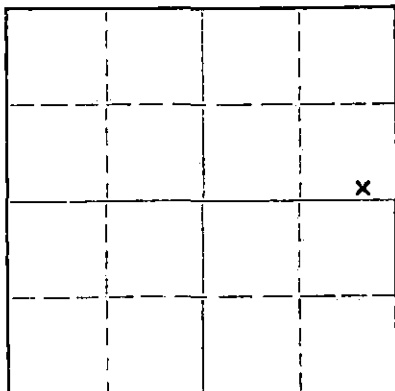

Locate well correctly on above
Section Plat

If a producing well is abandoned, date of last production 19__
Was permission obtained from the Conservation Division or its agents before plugging was commenced? yes

Name of Conservation Agent who supervised plugging of this well Hugh Scott
Producing formation _____ Depth to top _____ Bottom _____ Total Depth of Well 2990 Feet
Show depth and thickness of all water, oil and gas formations.

OIL, GAS OR WATER RECORDS

CASING RECORD

FORMATION	CONTENT	FROM	TO	SIZE	PUT IN	PULLED OUT
				8 5/8	125	none
				5 1/2	2967	2526

Describe in detail the manner in which the well was plugged, indicating where the mud fluid was placed and the method or methods used in introducing it into the hole. If cement or other plugs were used, state the character of same and depth placed, from _____ feet to _____ feet for each plug set.

Fill hole with sand from 2990' to 2950' and dump 5 sacks of cement

Pull pipe

Mud hole to 160'

Set 10' rock bridge from 160' to 150' and dump 25 sacks of cement

Mud hole to 30' and dump 10 sacks of cement

RECEIVED
STATE CORPORATION COMMISSION
AUG 15 1966

CONSERVATION DIVISION
WICHITA, KANSAS

(If additional description is necessary, use BACK of this sheet)
Name of Plugging Contractor Flint Engineering and Construction Co.
Address 2375 W. Central El Dorado, Kansas

STATE OF Kansas, COUNTY OF Butler, ss.

(employee of owner) or (owner or operator) of the above-described well, being first duly sworn on oath, says: That I have knowledge of the facts, statements, and matters herein contained and the log of the above-described well as filed and that the same are true and correct. So help me God.


(Signature) Jeanne Davis

SUBSCRIBED AND SWORN TO before me this 12 day of August, 19 66

(Address) _____
Ronald R. Benson

Notary Public.

My commission expires Sept. 27, 1967

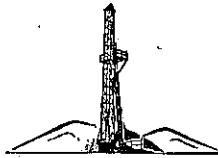

Blackstone Drilling, Inc.

Box 455 • 523 West Kansas • Phone CH 1-1250

McPHERSON • KANSAS
67460

December 3, 1965

COMPANY: GEORGE R. HESS & SONS
 CONTRACTOR: BLACKSTONE DRILLING, INC.
 FARM: FRANK UNRUH #3
 LOCATION: SE/4 SE/4 NE/4, Sec. 3-20-2W,
 McPherson County, Kansas
 COMMENCED: November 27, 1965
 COMPLETED: December 3, 1965
 ELEVATION:

0	to	40	Sandy Clay
40	to	125	Shale & Shells
125	to	490	Shale & Lime
490	to	795	Lime
795	to	2215	Lime & Shale
2215	to	2295	Shale
2295	to	2570	Lime
2570	to	2915	Lime & Shale
2915	to	2931	Shale
2931	to	2990	Mississippi
		2990	T. D.

RECEIVED

Cut 12 1/4 in. hole to 125 ft. and run 129 ft. of 8 5/8 in. surface casing and cemented on bottom at 125 ft. with 85 sacks cement and 1 sack calcium chloride. Plug down at 12:00 A.M., November 18, 1965. Cut 7 7/8 in. hole to 2990 ft. and run 2993 ft. of 5 1/2 in. pipe and cemented 23' foot off bottom with 40 sacks cement. Plug down at 10:00 A.M., December 3, 1965.

TOPS: Brown Lime - 2235' Kansas City - 2290' Mississippi - 2931'

Measurements taken from K. B.

CERTIFICATE

I, H. J. Plouffe, President of Blackstone Drilling, Inc. do hereby certify that the above and foregoing is a true and correct copy of log on your Frank Unruh #3, located on the SE/4 SE/4 NE/4 of Sec. 3-20-2W, McPherson County, Kansas as reflected by the files of Blackstone Drilling, Inc.

H. J. Plouffe
 H. J. Plouffe, President

Subscribed and sworn to before me a Notary Public in and for McPherson County, Kansas this 6th day of December, 1965.

Ruth McVay
 Ruth McVay - Notary Public

My Commission Expires: December 18, 1965.