


WELL PLUGGING RECORD

Give All Information Completely
Make Required Affidavit
Mail or Deliver Report to:
Conservation Division
State Corporation Commission
800 Bittling Building
Wichita, Kansas

Pawnee County, Sec. 29 Twp. 23 Rge. 15 (E) W (W)

Location as "NE/CNW/SW" or footage from lines Gen. SW SW SW
Lease Owner Cities Service Oil Company
Lease Name Becker "C" Well No. 2
Office Address Great Bend, Kansas
Character of Well (completed as Oil, Gas or Dry Hole) Dry Hole
Date well completed June 29, 19 55
Application for plugging filed June 29, 19 55
Application for plugging approved June 29, 19 55
Plugging commenced June 29, 19 55
Plugging completed June 29, 19 55
Reason for abandonment of well or producing formation Dry Hole

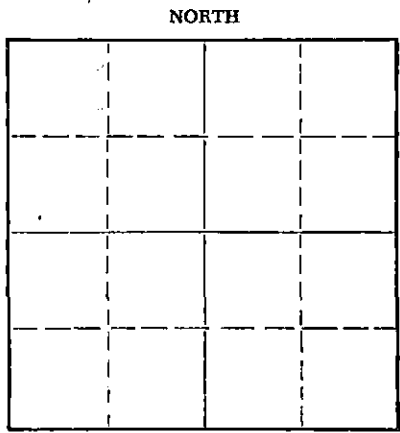

Locate well correctly on above Section Plat

If a producing well is abandoned, date of last production _____ 19____
Was permission obtained from the Conservation Division or its agents before plugging was commenced? Yes

Name of Conservation Agent who supervised plugging of this well Warren Horner
Producing formation Lansing-Kansas City Depth to top 3628 Bottom 3870 Total Depth of Well 3870 Feet
Show depth and thickness of all water, oil and gas formations.

OIL, GAS OR WATER RECORDS

CASING RECORD

FORMATION	CONTENT	FROM	TO	SIZE	PUT IN	PULLED OUT
				8-5/8"	404'	None

Describe in detail the manner in which the well was plugged, indicating where the mud fluid was placed and the method or methods used in introducing it into the hole. If cement or other plugs were used, state the character of same and depth placed, from _____ feet to _____ feet for each plug set.

3870-300' mud.
300-230' wood plug, hulls and soil bridge and 20 sacks cement.
230- 35' mud.
35' to base of cellar, wood plug, hulls and 10 sacks cement.

(If additional description is necessary, use BACK of this sheet)

Name of Plugging Contractor Brack Drilling Company
Address Wichita, Kansas

STATE OF Kansas, COUNTY OF Barton, ss.
V. M. Conover (employee of owner) of the above-described well, being first duly sworn on oath, says: That I have knowledge of the facts, statements, and matters herein contained and the log of the above-described well as filed and that the same are true and correct. So help me God.

(Signature) V.M. Conover
Box 751, Great Bend, Kansas
(Address)

SUBSCRIBED AND SWORN TO before me this 8th day of July, 19 55.

W.G. Smith
Notary Public.

My commission expires March 12, 1959.

PLUGGING
FILE SEC 27 T 23 R 15W
BOOK 132 PAGE 7

CONSERVATION DIVISION
WICHITA, KANSAS

7-12-55

WELL RECORD

15.145.01078.0000

Company Oil Service Oil Company Well No. 2 Farm Becker #8
 Location 330' North and 330' East of SW Corner Sec. 29 T. 23 R. 15W
 Elevation 2048 (2045 Cr.) County Pawnee State Kansas
 Drlg. Comm. June 16, 1955 Contractor Brack Drilling Company
 Drlg. Comp. June 23, 1955 Acid None
 T. D. 3870' Initial Prod. Dry Hole - P. & A. 6-29-55.

CASING RECORD:

8-5/8" @ 404' ocm. 250 sx cement

FORMATION RECORD:

sand	0-95
sand & shale	600
shale & shells	920
anhydrite	960
shale & shells	1000
red bed & shale	1100
shale & lime	1640
lime & shale	2170
lime	2350
lime & shale	2645
lime	2685
broken lime	2775
lime & shale	2870
lime	3060
lime & shale	3280
lime	3447
lime & shale	3524
lime	3575
shale	3647
lime	3870 T. D.

Hestrier	3495'
Brown Limestone	3621'
Lansing	3628'
Penetration	242'
Total Depth	3870'

Drill stem test 3757-82, open 1 hr., recovered 8' mud; B. H. P. 40#/30 mins.

Drill stem test 3784-3808, open 1 hr., recovered 30' mud; B. H. P. 54.5#/30 mins.

Drill stem test 3808-45, open 1 hr., recovered 55' mud; B. H. P. 950#/30 mins.

Drill stem test 3845-70, open 1 hr., recovered 20' mud; B. H. P. 0#/30 mins.

Drill stem test (straddle packers) 3612-48, open 1 hr., recovered 30' mud; B. H. P. 160#/30 mins.

SLOPE TESTS (SURE SHOT):

400'	1°
1025'	3/4°
1520'	1/2°
2000'	3/4°
2500'	1°
3000'	1/4°
3500'	1/4°

PLUGGING
 FILE SEC 29 T 23 R 15W
 BOOK PAGE 122 LINE 7