


WELL PLUGGING RECORD

Give All Information Completely  
Make Required Affidavit  
Mail or Deliver Report to:  
Conservation Division  
State Corporation Commission  
211 No. Broadway  
Wichita, Kansas.

NORTH

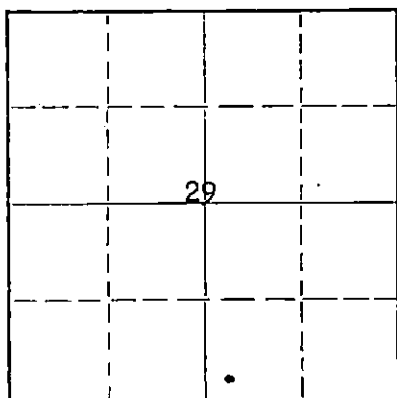

Locate well correctly on above  
Section Plat

Pawnee County. Sec. 29 Twp. 23 S Rge. 15 (E) 15 (W)  
Location as "NE/CNWxSWx" or footage from lines Ctr. SW/4 SW/4 SE/4  
Lease Owner Monsanto Chemical Company (Lion Oil Company Division)  
Lease Name Petro Well No. 1  
Office Address P. O. Box 580, Pratt, Kansas  
Character of Well (completed as Oil, Gas or Dry Hole) Gas  
Date well completed May 8, 19 52  
Application for plugging filed September 30, 19 57  
Application for plugging approved October 2, 19 57  
Plugging commenced October 3, 19 57  
Plugging completed October 7, 19 57  
Reason for abandonment of well or producing formation No commercial production

If a producing well is abandoned, date of last production February, 19 57  
Was permission obtained from the Conservation Division or its agents before plugging was commenced? Yes

Name of Conservation Agent who supervised plugging of this well Mr. Donald Truan  
Producing formation Arbuckle Depth to top 4087' Bottom 4175' Total Depth of Well 4175' Feet  
Show depth and thickness of all water, oil and gas formations.

OIL, GAS OR WATER RECORDS

CASING RECORD

FORMATION	CONTENT	FROM	TO	SIZE	PUT IN	PULLED OUT
Arbuckle	Gas	4087'	4130'	8-5/8"	432'	None
				5 1/2"	4164'	2882'

Describe in detail the manner in which the well was plugged, indicating where the mud fluid was placed and the method or methods used in introducing it into the hole. If cement or other plugs were used, state the character of same and depth placed, from \_\_\_\_\_ feet to \_\_\_\_\_ feet for each plug set.

Set Bridging plug @ 3930' with 10 sacks of cement on top of plug.  
Filled hole with heavy mud to 300', set rock plug @ 300' with 25  
sacks of cement on top of plug. Filled hole with heavy mud to 30',  
set rock plug @ 30' with 10 sacks of cement to surface of ground.

CONSERVATION DIVISION  
OCT 18 1957  
WICHITA, KANSAS

(If additional description is necessary, use BACK of this sheet)  
Name of Plugging Contractor West Supply Company, Inc.  
Address 1707 Helser St., Great Bend, Kansas

STATE OF KANSAS, COUNTY OF PRATT, ss.  
Bruce E. Roll (employee of owner) or (owner or operator) of the above-described well, being first duly sworn on oath, says: That I have knowledge of the facts, statements, and matters herein contained and the log of the above-described well as filed and that the same are true and correct. So help me God.

(Signature) Bruce E. Roll  
P. O. Box 580, Pratt, Kansas  
(Address)

SUBSCRIBED AND SWORN to before me this 9th day of October, 19 57

Mark F. Combs  
Notary Public.

My commission expires September 19, 1957

PLUGGING  
FILE SEC 29 T. 23 R. 15W  
BOOK PAGE 50 LINE 5

15.145.01382.0000

SW SW SE  
SEC. 29-23S-15W  
PAWNEE COUNTY, KANSAS

PETRO WELL No. 1

CONTRACTOR: THE R. W. RINE DRILLING COMPANY

STARTED: APRIL 14, 1952

FINISHED: MAY 4, 1952

LOG

SHALE	0 - 40	
SAND	40 - 130	8-5/8" @ 432' w/275 SK. & 2 SK. C.C.
CLAY AND RED BED	130 - 440	
CEMENT, RED BED	440 - 790	Syfo @ 500' - 1/2"
RED BED	790 - 950	
ANHYDRITE	950 - 960	
SALT AND SHALE	960 - 1520	Syfo @ 1000' - 1/2"
SHALE, SALT, SHELLS	1520 - 1850	Syfo @ 1500' - OK
LIME	1850 - 2385	Syfo @ 2000' - OK
LIME	2385 - 2840	Syfo @ 2500' - 1/2"
LIME	2840 - 2905	
LIME AND SHALE	2905 - 3349	
LIME	3349 - 3395	
LIME AND SHALE	3395 - 3494	FISHING - DP-STUCK @ 3494'
LIME	3494 - 3505	
SHALE AND LIME	3505 - 3630	Syfo @ 3500' - 1/2"
LIME	3630 - 3678	
LIME	3678 - 3980	
LIME, CHERT	3980 - 4023	
CHERT	4023 - 4053	
SHALE AND SAND	4053 - 4088	
SHALE	4088 - 4148	
ARB. LIME	4148 - 4173	T.D. 133 JTS. 5 1/2" Csg. @ 4171' w/200 SK.

I, R. M. GREEN, DO HEREBY CERTIFY THAT THE ABOVE IS A TRUE AND ACCURATE LOG OF THE PETRO WELL No. 1, LOCATED SW SW SE, SECTION 29-23S-15W, PAWNEE COUNTY, KANSAS.

*R. M. Green*  
ASSISTANT SECRETARY

SUBSCRIBED TO AND SWORN BEFORE ME THIS 8TH DAY OF MAY, 1952.

*Leona Pederson*  
NOTARY PUBLIC

MY COMMISSION EXPIRES APRIL 20, 1955.

STATE OF KANSAS

CONSERVATION DIVISION  
Wichita, Kansas

PLUGGING	
FILE	SEC. 29 T. 23 R. 15W
BOOK	PAGE 50 LINE 5