


STATE OF KANSAS
STATE CORPORATION COMMISSION

WELL PLUGGING RECORD

Give All Information Completely
Make Required Affidavit
Mail or Deliver Report to
Conservation Division
State Corporation Comm.
245 North Water
Wichita, KS 67202

PAWNEE County. Sec. 14 Twp. 21S Rge. 19W E/W
Location as "NE/CNW $\frac{1}{4}$ SW $\frac{1}{4}$ " or footage from lines _____
NE SW SE
Lease Owner PICKRELL DRILLING COMPANY
Lease Name Coteman "C" Well No. 1
Office Address 205 Litwin Bldg. Wichita, Ks. 67202
Character of Well (Completed as Oil, Gas or Dry Hole) _____
Dry Hole
Date Well completed 2-4-77 19
Application for plugging filed 2-4-77 19
Application for plugging approved 2-4-77 19
Plugging commenced 2-4-77 19
Plugging completed 2-4-77 19
Reason for abandonment of well or producing formation _____
Dry Hole
If a producing well is abandoned, date of last production _____
19

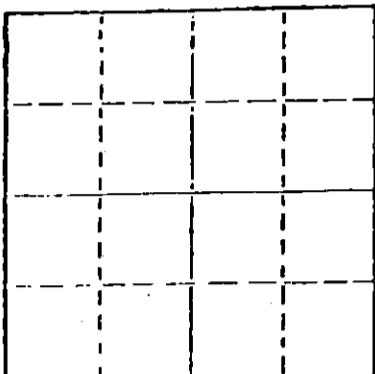

Locate well correctly on above
Section Plot

Name of Conservation Agent who supervised plugging of this well Leo Massey
Producing formation _____ Depth to top _____ Bottom _____ Total Depth of Well 4265
Show depth and thickness of all water, oil and gas formations.

OIL, GAS OR WATER RECORDS

CASING RECORD

FORMATION	CONTENT	FROM	TO	SIZE	PUT IN	PULLED OUT
				8 5/8	332	None

Describe in detail the manner in which the well was plugged, indicating where the mud fluid was placed and the method or methods used in introducing it into the hold. If cement or other plugs were used, state the character of same and depth placed, from _____ feet to _____ feet for each plug set.

Squeezed at surface with 125 sx. Comp. 12:30PM
2-4-77

RECEIVED
STATE CORPORATION COMMISSION

FEB 22 1977

CONSERVATION DIVISION
Wichita, Kansas

(If additional description is necessary, use BACK of this sheet)

Name of Plugging Contractor PICKRELL DRILLING COMPANY

STATE OF KANSAS COUNTY OF SEDGWICK, ss.
C. W. Sebitts (employee of owner) or (owner or operator)

of the above-described well, being first duly sworn on oath, says: That I have knowledge of the facts, statements, and matters herein contained and the log of the above-described well as filed and that the same are true and correct. So help me God.

(Signature)

BY: C. W. Sebitts
205 Litwin Bldg. Wichita, Ks. 67202
(Address)

SUBSCRIBED AND SWORN TO before me this 16 day of February, 19 77

My commission expires _____

Jo Ann Sarver
Notary Public.



ROTARY DRILLING LOG

COMPANY: PICKRELL DRILLING COMPANY
205 LITWIN BLDG.,
WICHITA, KS. 67202
LOCATION: COLEMAN "C" #
1 NE SW SE Sec. 14-21S-19W
Paqnee Co., Ks.
CONTRACTOR: **PICKRELL DRILLING COMPANY**
Wichita, Kansas

Rotary Drilling Commenced 1-26-77
Rotary Drilling Completed 2-04-77

CASING RECORD: Spud date 1/26/77 set at 332' with 175 sx. Comp. 1-26-77 9:30 PM

LOG

(Figures indicate bottom of formation — measurements from top of rotary bushing.)

Top Soil & Shale	346
Shale	500
Shale & Shells	625
Shale	780
Shale	1207
Shale	1234
Shale	1370
Shale & Shells	2000
Lime & Shale	2170
Lime & Shale	2325
Lime & Shale	2515
Lime & Shale	2695
Lime & Shale	2900
Lime & Shale	3095
Lime & Shale	3270
Lime & Shale	3405
Lime & Shale	3600
Lime & Shale	3690
Lime	3760
Lime & Shale	3855
Lime & Shale	3930
Lime	3995
Lime & Shale	4055
Lime & Shale	4135
Lime	4160
Lime & Sand	4190
Lime & Shale	4265

RECEIVED
STATE CORPORATION COMMISSION
FEB 22 1977
CONSERVATION DIVISION
Wichita, Kansas

The undersigned, C. W. Sebitts, Attorney-in-Fact for PICKRELL DRILLING COMPANY, hereby certifies in behalf of said Company, that the above is a true and correct log of the formation encountered in drilling the above well as reflected by the Daily Drilling Reports.

PICKRELL DRILLING COMPANY
By [Signature]
Attorney-in-Fact
C. W. Sebitts

STATE OF KANSAS }
COUNTY OF SEDGWICK } ss.:

On this 16 day of February, 19 77, before me the undersigned, a Notary Public, in and for

the County and State aforesaid, personally appeared C. W. Sebitts, to me known to be the identical person who subscribed the name of PICKRELL DRILLING COMPANY to the foregoing instrument as its Attorney-in-Fact and acknowledged to me that he executed the same as his free and voluntary act and deed, and as the free and voluntary act and deed of such company, for the uses and purposes therein set forth.

Given under my hand and seal of office the day and year last above written.

My commission expires: _____

[Signature]
Notary Public

Jo Ann Sarver

