

STATE OF KANSAS
STATE CORPORATION COMMISSION

Give All Information Completely
Make Required Affidavit
Mail or Deliver Report to:
Conservation Division
State Corporation Commission
212 No. Market
Wichita, Kansas

WELL PLUGGING RECORD

Stafford County, Sec. 25 Twp. 21 Rge. 11 West (X) (W)

Location as "NE/CNW/SW" or footage from lines SW/4 NE/4 NW/4

Lease Owner F. G. Holl

Lease Name ESPEY Well No. 1

Office Address 6427 East Kellogg - Wichita, Kansas

Character of Well (completed as Oil, Gas or Dry Hole) Dry Hole

Date well completed May 28 19 70

Application for plugging filed " " 19 "

Application for plugging approved " 19 "


Plugging commenced " 19 "

Plugging completed May 29 19 "

Reason for abandonment of well or producing formation

If a producing well is abandoned, date of last production 19

Was permission obtained from the Conservation Division or its agents before plugging was commenced? yes

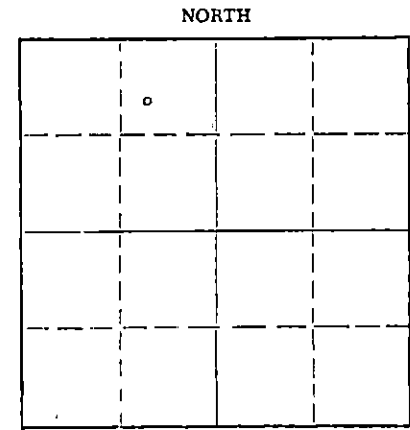

Locate well correctly on above Section Flat

Name of Conservation Agent who supervised plugging of this well G. Russell Biberstein

Producing formation Depth to top Bottom Total Depth of Well 3466 Feet

Show depth and thickness of all water, oil and gas formations.

OIL, GAS OR WATER RECORDS

CASING RECORD

FORMATION	CONTENT	FROM	TO	SIZE	PUT IN	PULLED OUT

Describe in detail the manner in which the well was plugged, indicating where the mud fluid was placed and the method or methods used in introducing it into the hole. If cement or other plugs were used, state the character of same and depth placed, from feet to feet for each plug set.

Hole full of heavy mud to 500' - Set plug - 50 sks. cement thru D.P. w/pump truck
Come up hole to 240' - plug - 25 sks. cement thru d.p. w/pump truck
Come up hole to 40' - Good bridge - 10 sks. cement
2 sks. cement in rat hole

RECEIVED
STATE CORPORATION COMMISSION
JUN 1 1970
CONSERVATION DIVISION
Wichita, Kansas

(If additional description is necessary, use BACK of this sheet)

Name of Plugging Contractor

Address

STATE OF Kansas COUNTY OF Barton, ss.

Larry Curtis (employee of owner) or (owner) of the above-described well, being first duly sworn on oath, says: That I have knowledge of the facts, statements, and matters herein contained and the log of the above-described well as filed and that the same are true and correct. So help me God

(Signature) Larry Curtis

Box 823-Great Bend, Kansas (Address)

SUBSCRIBED AND SWORN to before me this 29 day of May, 19 70

My commission expires 4-11-74

Dorothy M. Hague Notary Public.

W E L L L O G

DATE COMMENCED: May 21, 1970
DATE COMPLETED: May 28, 1970

F. G. Holl
ESPEY #1
SW/4 NE/4 NW/4
Sec. 25-T21s-R11w
Stafford County, Kansas

ELEVATION: 1750 K.B.

0	-	160'	Clay & Sand
160	-	175'	Sand
175	-	365'	Red Bed
365	-	387'	Anhydrite
387	-	461'	Shale & Sand Streaks
461	-	474'	Anhydrite
474	-	1530'	Shale & Shells
1530	-	1785'	Lime & Shale
1785	-	1995'	Lime
1995	-	2700'	Lime & Shale
2700	-	2931'	Lime
2931	-	2936'	Shale
2936	-	2950'	Lime & Shale
2950	-	2963'	Lime
2963	-	3069'	Shale
3069	-	3085'	Lime & Shale
3085	-	3320'	Lime
3320	-	3370'	Shale
3370	-	3457'	Chert
3457	-	3466'	Dolomite
		3466'	RTD

FORMATION DATA

ANHYDRITE	461
HOWARD	2537
SEVERY SAND	2588
TOPEKA	2642
HEEBNER	2931
TORONTO	2950
DOUGLAS	2963
BROWN LIME	3069
KANSAS CITY	3085
BASE K.C.	3320
CONGL. CHERT	3370
VIOLA CHERT	3380
ARBUCKLE	3451
RTD	3466

RECEIVED
STATE CORPORATION COMMISSION
JUN 1 1970
CONSERVATION DIVISION
Wichita, Kansas

SURFACE PIPE: Set new
8-5/8" at 250' with 225
sacks cement.

A F F I D A V I T

STATE OF KANSAS
COUNTY OF BARTON) ss.

Larry Curtis of lawful age, does swear and state that the facts and statements herein contained are true and correct to the best of his knowledge.

Larry Curtis

Subscribed and sworn to before me this 29 day of May, 1970

My Comm. Expires:

April 11, 1972

Dorothy M. Hager
Notary Public