


STATE OF KANSAS
STATE CORPORATION COMMISSION

WELL PLUGGING RECORD

Give All Information Completely
Make Required Affidavit
Mail or Deliver Report to:
Conservation Division
State Corporation Commission
212 No. Market
Wichita, Kansas

NORTH

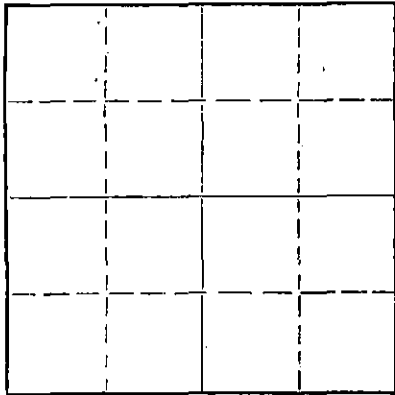

Locate well correctly on above
Section Plat

Location as "NE/CNW%SW%" or footage from lines C SW SE County. Sec. 3 Twp. 21S Rge. 9W ~~(E)~~ (W)
Lease Owner A. Scott Ritchie
Lease Name Jeter Well No. 1
Office Address 413 Union Center Bldg. Wichita, Ks. 67202
Character of Well (completed as Oil, Gas or Dry Hole) Dry Hole
Date well completed 7-23-67 19
Application for plugging filed 7-23-67 19
Application for plugging approved 7-23-67 19
Plugging commenced 7-23-67 19
Plugging completed 7-23-67 19
Reason for abandonment of well or producing formation Dry Hole

If a producing well is abandoned, date of last production _____ 19
Was permission obtained from the Conservation Division or its agents before plugging was commenced? yes

Name of Conservation Agent who supervised plugging of this well Gilbert Toman
Producing formation _____ Depth to top _____ Bottom _____ Total Depth of Well 3000 Feet
Show depth and thickness of all water, oil and gas formations.

OIL, GAS OR WATER RECORDS

CASING RECORD

FORMATION	CONTENT	FROM	TO	SIZE	PUT IN	PULLED OUT
				8 5/8"	228'	none

Describe in detail the manner in which the well was plugged, indicating where the mud fluid was placed and the method or methods used in introducing it into the hole. If cement or other plugs were used, state the character of same and depth placed, from _____ feet to _____ feet for each plug set.

Mud to 215', plug, 1/4 sk. hulls, 25 sks. cement through drill pipe
Mud to 40', 1/2 sk. hulls, 10 sks. cement & Plug
2 sks. cement in rathole

RECEIVED
STATE CORPORATION COMMISSION

7-26-67 JUL 26 1967

CONSERVATION DIVISION
Wichita, Kansas

(If additional description is necessary, use BACK of this sheet)

Name of Plugging Contractor Leben Drilling, Inc.
Address Box 486, Great Bend, Kansas 67530

STATE OF KANSAS, COUNTY OF BARTON, ss.
Leslie Kite (employee of owner) or (owner or operator) of the above-described well, being first duly sworn on oath, says: That I have knowledge of the facts, statements, and matters herein contained and the log of the above-described well as filed and that the same are true and correct. So help me God.

(Signature) Leslie Kite

Box 486, Great Bend, Kansas 67530
(Address)

SUBSCRIBED AND SWORN TO before me this 25th day of July, 1967

My commission expires April 1, 1971

Ulanda Nichols
Notary Public.

DRILLER'S LOG

COMPANY: A. SCOTT RITCHIE
 CONTRACTOR: Leben Drilling, Inc.
 FARM: JETER #1
 LOCATION: C SW SE SEC. 3-21S-9W
 RICE COUNTY, KANSAS
 COMMENCED: 7-18-67
 COMPLETED: 7-23-67

0	90	Sand, Subsoil
90	228	Redbed
228	255	Shale
255	263	Anhydrite
263	1075	Shale
1075	1180	Shale, Lime Streaks
1180	2695	Lime, Shale
2695	3000	Lime
	<u>3000</u>	<u>RTD - D. & A.</u>

RECEIVED
STATE CORPORATION COMMISSION

JUL 26 1967

CONSERVATION DIVISION
Wichita, Kansas

8 5/8" used surface casing set @ 228' cemented with 175 sacks of Common, 2% cc. Cement did not circulate, cement down 15', cemented through 1" pipe.

I, Leslie Kite, do hereby certify that the above and foregoing is a true and correct copy of the log of the Jeter #1 Well, located C SW SE of Section 3, Township 21 South, Range 9 West, Rice County, Kansas, as reflected by the records of Leben Drilling, Inc.

Leslie Kite

Leslie Kite

STATE OF KANSAS)
COUNTY OF BARTON) SS

Subscribed and sworn to and before me, a Notary Public, in and for Barton County, Kansas, this 25th day of July, 1967.

Ulanda Nichols

Ulanda Nichols

My Commission Expires
April 1, 1971