


WELL PLUGGING RECORD

Give All Information Completely
Make Required Affidavit
Mail or Deliver Report to:
Conservation Division
State Corporation Commission
211 No. Broadway
Wichita, Kansas

Rice County, Sec. 3 Twp. 21S Rge. 9 (W)

Location as "NE/CNW4SW4" or footage from lines Ctr. SW NW
Lease Owner Champlin Petroleum Company
Lease Name Frederick Well No. 1
Office Address P. O. Box 308, Ellinwood, Kansas
Character of Well (completed as Oil, Gas or Dry Hole) Dry hole
Date well completed July 17 19 67
Application for plugging filed July 17 19 67
Application for plugging approved July 17 (Verbal) 19 67
Plugging commenced July 17 19 67
Plugging completed July 17 19 67
Reason for abandonment of well or producing formation Dry Hole

NORTH

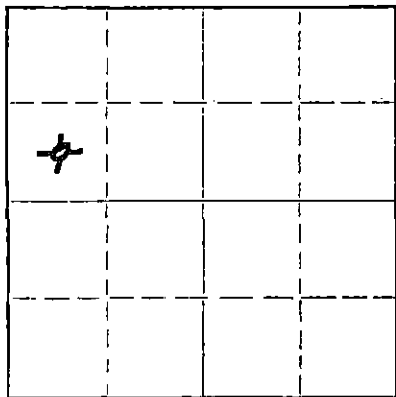

Locate well correctly on above Section Plat

If a producing well is abandoned, date of last production _____ 19____
Was permission obtained from the Conservation Division or its agents before plugging was commenced? yes

Name of Conservation Agent who supervised plugging of this well Gilbert Toman
Producing formation _____ Depth to top _____ Bottom _____ Total Depth of Well 3418' Feet
Show depth and thickness of all water, oil and gas formations.

OIL, GAS OR WATER RECORDS

CASING RECORD

FORMATION	CONTENT	FROM	TO	SIZE	PUT IN	PULLED OUT
				8 5/8" OD	264'	None

Describe in detail the manner in which the well was plugged, indicating where the mud fluid was placed and the method or methods used in introducing it into the hole. If cement or other plugs were used, state the character of same and depth placed, from _____ feet to _____ feet for each plug set.

Filled hole with heavy rotary mud from 3418' TD to 250', pushed wood plug and 1/2 sack of hulls to 250' and pumped in 25 sacks of cement then filled hole with heavy mud to 40' and pushed in wood plug and 1/2 sack of hulls (held Kelly) and pumped in 10 sacks of cement filling hole to bottom of cellar. Bridged rat hole with 2 sacks of cement.

RECEIVED
STATE CORPORATION COMMISSION

JUL 19 1967

CONSERVATION DIVISION
Wichita, Kansas

(If additional description is necessary, use BACK of this sheet)
Name of Plugging Contractor Leben Drilling Company
Address 815 Wichita Plaza, Wichita, Kansas

STATE OF Kansas, COUNTY OF Barton, ss.
J. W. Meyers (employee of owner) or (~~owner or operator~~) of the above-described

well, being first duly sworn on oath, says: That I have knowledge of the facts, statements, and matters herein contained and the log of the above-described well as filed and that the same are true and correct. So help me God.

(Signature) J. W. Meyers
J. W. Meyers, District Operations Mgr.
P. O. Box 308, Ellinwood, Kansas
(Address)

SUBSCRIBED AND SWORN TO before me this 17th day of July 19 67

My commission expires 5/22/70
N. Kenneth Stivers Notary Public.

15.159.20049.0000

CHAMPLIN PETROLEUM COMPANY
FREDERICK #1
TOBIAS FIELD AREA
LOCATION: Ctr. SW NW, Sec. 3-21S-9W
RICE COUNTY, KANSAS

DRILLER'S FORMATION LOG

0' - 90' Sand and sub soil
90' - 264' Red bed
264' - 280' Shale & sand
280' - 1320' Shale
1320' - 1365' Shale and lime streaks
1365' - 2505' Lime and shale
2505' - 3418' Lime
3418' - T.D.

RECEIVED
STATE CORPORATION COMMISSION

JUL 19 1967

CONSERVATION DIVISION
Wichita, Kansas

DRILLER'S LOG

COMPANY: Champlin Petroleum Company
 CONTRACTOR: LEBEN DRILLING, INC.
 FARM: G. C. FREDERICK #1
 LOCATION: C SW NW SEC. 3-21S-9W
 RICE COUNTY, KANSAS
 COMMENCED: 7-10-67
 COMPLETED: 7-17-67

0	90	Sand, Subsoil
90	264	Redbed
264	280	Shale, Hard Sand
280	525	Shale
525	1365	Shale, Lime Streaks
1365	2505	Lime, Shale
2505	3418	Lime
	<u>3418</u>	<u>RTD - D. & A.</u>

8 5/8" new 20# surface casing set @ 261' cemented with 190 sacks Quickset, 2% gel

I, Leslie Kite, do hereby certify that the above and foregoing is a true and correct copy of the log of the G. C. Frederick #1 Well, located C SW NW of Section 3, Township 21 South, Range 9 West, Rice County, Kansas, as reflected by the records of Leben Drilling, Inc.

Leslie Kite
 RECEIVED
 LESLIE KITE STATE CORPORATION COMMISSION

JUL 21 1967

STATE OF KANSAS)
) SS
 COUNTY OF BARTON)

CONSERVATION DIVISION
 Wichita, Kansas

Subscribed and sworn to and before me, a Notary Public, in and for Barton County, Kansas, this 20th day of July, 1967.

Ulanda Nichols
 Ulanda Nichols

My Commission Expires:
 April 1, 1971