

15.047.30068.00.00


STATE OF KANSAS
STATE CORPORATION COMMISSION

Form CP-4

WELL PLUGGING RECORD

Give All Information Completely
Make Required Affidavit
Mail or Deliver Report to:
Conservation Division
State Corporation Commission
211 No. Broadway
Wichita, Kansas

NORTH

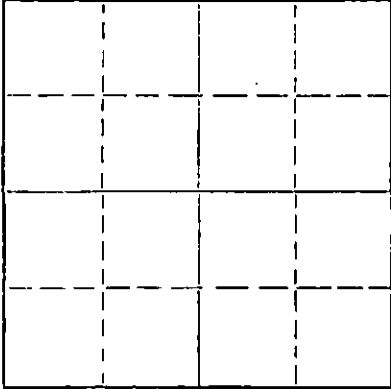

Locate well correctly on above
Section Plat

Edwards County. Sec. 9 Twp. 23 Rge. (E) 20 (W)
Location as "NE/CNW/SW" or footage from lines C NE NW
Lease Owner Emil Ogden
Lease Name Groner Well No. 1
Office Address 10 Cambrian Bldg. Abilene Texas
Character of Well (completed as Oil, Gas or Dry Hole) Dry Hole
Date well completed Dec. 28 19 65
Application for plugging filed Dec. 28 19 65
Application for plugging approved Dec. 28 19 65
Plugging commenced Dec. 28 19 65
Plugging completed Dec. 28 19 65
Reason for abandonment of well or producing formation Dry

If a producing well is abandoned, date of last production 19
Was permission obtained from the Conservation Division or its agents before plugging was commenced? Yes

Name of Conservation Agent who supervised plugging of this well Archie V. Elving
Producing formation _____ Depth to top _____ Bottom _____ Total Depth of Well 4627 Feet
Show depth and thickness of all water, oil and gas formations.

OIL, GAS OR WATER RECORDS

CASING RECORD

FORMATION	CONTENT	FROM	TO	SIZE	PUT IN	PULLED OUT
				8 5/8	307'	

Describe in detail the manner in which the well was plugged, indicating where the mud fluid was placed and the method or methods used in introducing it into the hole. If cement or other plugs were used, state the character of same and depth placed, from _____ feet to _____ feet for each plug set.

Bottom plug @ 300' w/25 sx
Top plug @ 40' w/10 sx

1-5-1965
RECEIVED
STATE CORPORATION COMMISSION
JAN 5 1966
CONSERVATION DIVISION
WICHITA, KANSAS

(If additional description is necessary, use BACK of this sheet)

Name of Plugging Contractor Woodman & Tannitti Drilling Company
Address 706 Union Nat'l. Bldg.

STATE OF Kansas, COUNTY OF Sedgwick, ss.
K. T. Woodman (employee of owner) or (owner or operator) of the above-described

well, being first duly sworn on oath, says: That I have knowledge of the facts, statements, and matters herein contained and the log of the above-described well as filed and that the same are true and correct. So help me God.

(Signature) K. T. Woodman
K. T. Woodman 706 Union Nat'l. Bldg.
(Address)

SUBSCRIBED AND SWORN TO before me this 30 day of Dec., 19 65

My commission expires Feb. 11, 1968
Justina Chamberlain Notary Public.

15.047.30068.00.00

KANSAS GEOLOGICAL SOCIETY
KANSAS WELL LOG BUREAU - KANSAS WELL SAMPLE BUREAU
KANSAS GEOLOGICAL SOCIETY BUILDING
508 EAST MURDOCK - WICHITA, KANSAS

COMPANY Emil Ogden
FARM Groner NO. 1

SEC. 9 T. 23 R. 20W
LOC. C NE ~~23~~ NW

TOTAL DEPTH
COMM. December 12, 1965 COMP. December 28, 1965
SHOT OR TREATED
CONTRACTOR Woodman & Iannitti Drilling Co.
ISSUED

COUNTY Edwards
KANSAS

CASING
20 10
15 8 5/8 @ 307' w/200 SX
12 6
13 5

ELEVATION 2260 KB
PRODUCTION D & A

FIGURES INDICATE BOTTOM OF FORMATIONS

- 120 Clay & Shale
- 220 Sand & Clay
- 309 Shale
- 530 Shale
- 820 Shale & Red Bed
- 920 Sand
- 1330 Red Bed
- 1372 Red Bed
- 1393 Anhy
- 1645 Red Bed & Shale
- 1865 Shale & Lime
- 2090 Lime & Shale
- 2290 Shale & Lime
- 2415 Lime
- 2485 Lime
- 2560 Lime
- 2700 Lime
- 2765 Lime
- 2855 Lime
- 2985 Lime
- 3090 Lime
- 3185 Lime
- 3390 Lime
- 3525 Lime
- 3715 Lime
- 3810 Lime
- 3945 Lime
- 4030 Lime
- 4125 Lime
- 4181 Lime
- 4275 Lime
- 4345 Lime
- 4440 Lime
- 4486 Lime
- 4547 Lime
- 4583 Lime & Chert
- 4604 Lime & Chert
- 4627 Lime

RECEIVED
DATE RECEIVED JAN 5 1966
CONSERVATION DIVISION
Wichita, Kansas

I certify the above to be a true and correct copy of the driller's log and the geological tops to the best of my knowledge and belief.

Woodman & Iannitti Drilling Co.

K. T. Woodman