


Give All Information Completely
Make Required Affidavit
Mail or Deliver Report to:
Conservation Division
State Corporation Commission
211 No. Broadway
Wichita, Kansas

15,047.10000.00.00

WELL PLUGGING RECORD

NORTH

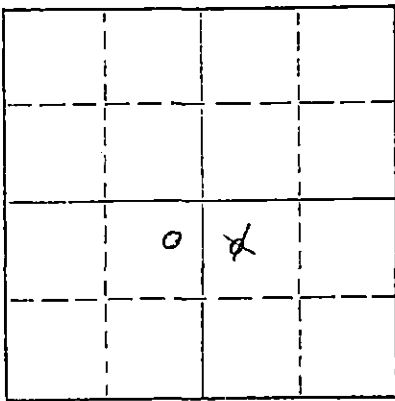

Locate well correctly on above
Section Plat

Edwards County. Sec. 5 Twp. 23S Rge. 20 (E) W (W)
Location as "NE/CNW/SW" or footage from lines C NW/4 SE/4 NE SW
Lease Owner Amarillo Oil Company
Lease Name Groner Well No. 1
Office Address P. O. Box 151, Amarillo, Texas
Character of Well (completed as Oil, Gas or Dry Hole) Dry Hole
Date well completed 6-16-62 19
Application for plugging filed 6-18-62 19
Application for plugging approved Verbal - 6-16-62 19
Plugging commenced 6-16-62 19
Plugging completed 6-16-62 19
Reason for abandonment of well or producing formation Dry Hole

If a producing well is abandoned, date of last production None 19
Was permission obtained from the Conservation Division or its agents before plugging was commenced? Yes

Name of Conservation Agent who supervised plugging of this well W. L. Lackamp
Producing formation None Depth to top Bottom Total Depth of Well 5060 Feet
Show depth and thickness of all water, oil and gas formations.

OIL, GAS OR WATER RECORDS

CASING RECORD

FORMATION	CONTENT	FROM	TO	SIZE	PUT IN	PULLED OUT
No producing gas, oil or water formations drilled in this well.		0	405	8-5/8"	405	0

Describe in detail the manner in which the well was plugged, indicating where the mud fluid was placed and the method or methods used in introducing it into the hole. If cement or other plugs were used, state the character of same and depth placed, from feet to feet for each plug set.

Hole was filled to 350' with mud. Wooden plug and 1/2 sack of hulls was placed @ 350'. 25 sx. of cement were mixed and spotted on top of plug thru drill pipe. Casing was then filled to 30' with mud and wooden plug and 1/2 sx. hulls placed on top of mud. Casing was then filled with cement from 30' to surface using 10 sacks cement.

RECEIVED
STATE CORPORATION COMMISSION

RECEIVED
STATE CORPORATION COMMISSION

DEC 17 1963

JUN 28 1962

CONSERVATION DIVISION
Wichita, Kansas

CONSERVATION DIVISION
Wichita, Kansas

6-28-62

(If additional description is necessary, use BACK of this sheet)

Name of Plugging Contractor Garvey Drilling Company
Address Route 2, Great Bend, Kansas

STATE OF Texas COUNTY OF Potter, ss.
J. A. Tipton (employee of owner) or (owner or operator) of the above-described

well, being first duly sworn on oath, says: That I have knowledge of the facts, statements, and matters herein contained and the log of the above-described well as filed and that the same are true and correct. So help me God.

(Signature)

Amarillo Oil Company, P. O. Box 151, Amarillo, Tex.
(Address)

SUBSCRIBED AND SWORN TO before me this 22 day of June, 1962

My commission expires June 1, 1963

Georgia J. Weathers
(Georgia J. Weathers) Notary Public.
Notary Public in and for Potter County, Texas

15.049.10000.00.00
WELL LOG

COMPANY **AMARILLO OIL COMPANY**
FARM **GRONER** NO. **1**

SEC. **5** T. **23S** R. **20W**
NE SW
LOC. **C-11, SE**


TOTAL DEPTH **5060'**

COUNTY **EDWARDS CO., KANSAS**

COMM. **May 30, 1962**

COMP. **June 16, 1962**

CONTRACTOR **GARVEY DRILLING COMPANY**

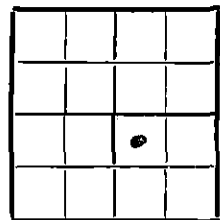

CASING **8-5/8" @ 405' w/250 sax.**

ELEVATION **2323' DF**

PRODUCTION **D & A**

FIGURES INDICATE BOTTOM OF FORMATIONS

395	Surface clay, sand & blue shale
600	Shale
799	Red bed
810	Anhydrite
850	Red bed
1700	Red bed & gyp
2265	Shale & shells
2345	Shale & lime
2490	Ft. Riley lime
2745	Lime & shade
2869	Lime
3580	Shale & lime
3845	Chalky lime
3963	Lime & shale
4025	Lime
4063	Cherty lime
4223	Lime
4283	Lime w/chert streaks
4375	Lime
4562	Lime & shale
4613	Sand & chert
4643	Chert & lime
4680	Lime & sand
4740	Lime
4745	Chert
4768	Sand & chert
4833	Lime
4873	Lime & shale
4957	Dolomite
4992	Shale & lime
5011	Arbuckle
5060	Dolomite
5060	T. D.

RECEIVED
STATE CORPORATION COMMISSION
JUN 28 1962
CONSERVATION DIVISION
Wichita, Kansas

State of KANSAS
County of BARTON } ss

I, VERNE A. MORRIS of GARVEY DRILLING COMPANY

upon oath state the above and foregoing is a true and correct copy of the log of the #1 GRONER well.

Subscribed and sworn to before me this 20th day of June 19 62
Verne A. Morris

My Commission Expires: November 12, 1962

Garvey
NOTARY PUBLIC