

15.047.30109.00.00

STATE OF KANSAS
STATE CORPORATION COMMISSION

WELL PLUGGING RECORD

Give All Information Completely
Make Required Affidavit
Mail or Deliver Report to:
Conservation Division
State Corporation Commission
800 Bittling Building
Wichita, Kansas


OR

Strike out upper line
when reporting plugging
of formations.

FORMATION PLUGGING RECORD

Edwards County Sec 21 Twp 23S Rge 19 # (E) W (W)

Location as "NE $\frac{1}{4}$ NW $\frac{1}{4}$ SW $\frac{1}{4}$ " or footage from lines SE $\frac{1}{4}$ NW $\frac{1}{4}$ NE $\frac{1}{4}$
Lease Owner Continental Oil Company
Lease Name George Krupp Well No. 1
Office Address Box 1267, Ponca City, Oklahoma
Character of Well (completed as Oil, Gas or Dry Hole) Dry Hole
Date well completed November 14, 19 45
Application for plugging filed November 19, 19 45
Application for plugging approved November 15, 19 45
Plugging commenced November 15, 19 45
Plugging completed November 15, 19 45
Reason for abandonment of well or producing formation No show of oil in any formation encountered.
If a producing well is abandoned, date of last production 19
Was permission obtained from the Conservation Division or its agents before plugging was commenced? Yes

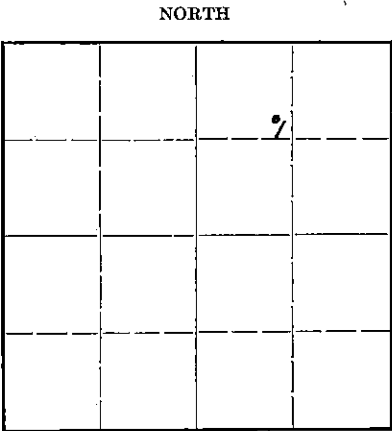

Locate well correctly on above Section Plat

Name of Conservation Agent who supervised plugging of this well R. Durkee, McPherson, Kansas
Producing formation Arbuckle Lime Depth to top 4996' Bottom 5028' Total Depth of Well 5028 Feet
Show depth and thickness of all water, oil and gas formations.

OIL, GAS OR WATER RECORDS


CASING RECORD

Formation	Content	From	To	Size	Put In	Pulled Out
	16"OD Surface casing				194'	None
	10 3/4"OD Intermediate string				1360'	None

Describe in detail the manner in which the well was plugged, indicating where the mud fluid was placed and the method or methods used in introducing it into the hold. If cement or other plugs were used, state the character of same and depth placed, from _____ feet to _____ feet for each plug set.

Hole was filled with heavy mud to within 300' of the top where a wood plug was set and cemented with 20 sacks of cement; hole was then filled with heavy mud to within 15' of the top where a second wood plug was set and capped with 5 sacks of cement.

21 23 1945
33 33

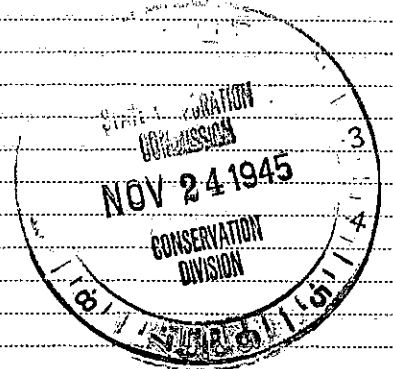

(If additional description is necessary, use BACK of this sheet)

Correspondence regarding this well should be addressed to Mr. F. L. Dunn
Address R. F. D. #4, Lyons, Kansas

STATE OF Kansas, COUNTY OF Rice, ss.
Mr. F. L. Dunn (employee of owner) or (owner or operator) of the above-described well,

being first duly sworn on oath, says: That I have knowledge of the facts, statements, and matters herein contained and the log of the above-described well as filed and that the same are true and correct. So help me God.

(Signature) *F. L. Dunn*
R. F. D. #4, Lyons, Kansas (Address)

SUBSCRIBED AND SWORN to before me this 21st day of November, 1945.

Louis McLine
Notary Public.

My commission expires October 21st, 1948.

FLD-EHD LPC
11-21-45 Corp. Comm.
File
Kennecott Copper Corp.

W E L L R E C O R D

George Krupp No. 1

Date Spudded: October 15, 1945
Date Completed: November 14, 1945
Date Plugged: November 15, 1945

Loc: 990'S and 990'E of N/4
corner of Sec. 21, T23S, R19W,
Edwards County, Kansas

FROM	TO	FORMATION	FROM	TO	FORMATION
0	850	Shale and shells	3970	4015	Shale and lime
850	1150	Sand and shale	4015	4040	Lime
1150	1352	Shale and shells	4040	4075	Lime and shale
1352	1375	Anhydrite	4075	4415	Lime
1375	2345	Shale and shells	4415	4465	Shale and lime
2345	2405	Lime and shale	4465	4510	Lime, chert & shale
2405	2735	Lime	4510	4579	Lime and shale
2735	3235	Broken lime	4579	4635	Chat
3235	3305	Shale and shells	4635	4670	Lime and shale
3305	3553	Lime and shale	4670	4695	Lime
3553	3934	Lime	4695	4725	Lime and shale
3934	3945	Shale	4725	4760	Lime
3945	3960	Lime	4760	4780	Lime and chert
			4780	5031	Lime

Elevation 2240'

Ran 194' of 16"OD 43.5# 3Ga. Armco Spiral Weld casing; set at 195'; cemented with 200 sacks of cement.

Ran 1360' of 10 3/4"OD 27# 3Ga. Armco Spiral Weld casing; set at 1365'; cemented with 850 sacks of cement.

- Top of Lansing Lime 4010'
- Top of Chat 4576'
- Top of Viola Lime 4845'
- Top of Simpson Sand 4947'
- Top of Arbuckle Lime 4996'

Well was drilled to a total depth of 5028' in Arbuckle lime. There was no show of oil in any formation.

11-14-45 - Ran Schlumberger survey. Survey did not indicate any possible productive zones.

11-15-45 - Plugged and abandoned. Well was neither shot nor acidized.

Total Depth 5028'

Note: All depths are calculated from derrick floor, except formation log which is calculated from rotary table.

I, the undersigned, being duly sworn upon oath, state that this Well Record is true, correct and complete according to the records of this office, and to the best of my knowledge and belief.

F. L. Quinn
District Superintendent

Subscribed and sworn to before me this 21st day of November, 1945.

Levin M. Gaine
Notary Public

My commission expires October 21st, 1948.

FLD-ERD
11-21-45
LPG-3
Corp. Comm.
Kennecott Copper Corp.
File

21 23 1945
33 33

NOV 24 1945
EDWARDS COUNTY, KANSAS