


15.047.00095.00.01

STATE OF KANSAS
STATE CORPORATION COMMISSION

WELL PLUGGING RECORD

Give All Information Completely
Make Required Affidavit
Mail or Deliver Report to:
Conservation Division
State Corporation Commission
800 Bittling Building
Wichita, Kansas

Edwards County. Sec. 18 Twp. 23 Rge. (E) 19 (W)
Location as "NE/CNW%SW%" or footage from lines NW NW NE
Lease Owner GRAMEHART-MILLER OIL COMPANY
Lease Name LIPPOLDT Well No. 1
Office Address 1005 East Second St., Wichita, Kansas
Character of Well (completed as Oil, Gas or Dry Hole) Dry Hole
Date well completed June 17 19 54
Application for plugging filed June 22 19 54
Application for plugging approved June 24 19 54
Plugging commenced June 28 19 54
Plugging completed June 28 19 54
Reason for abandonment of well or producing formation - - - - -
Dry Hole

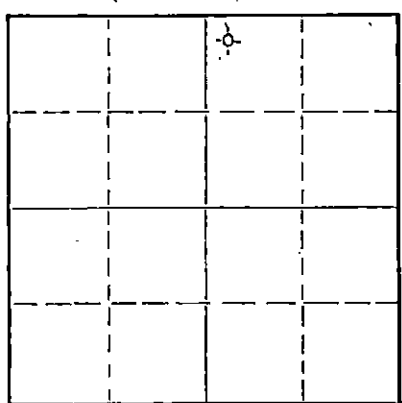

Locate well correctly on above Section Plat

If a producing well is abandoned, date of last production - - - - - 10
Was permission obtained from the Conservation Division or its agents before plugging was commenced? es

Name of Conservation Agent who supervised plugging of this well M. A. Rives, Box 8 Pratt, Kansas
Producing formation - - - - - Depth to top - - - - - Bottom - - - - - Total Depth of Well 1975 Feet
Show depth and thickness of all water, oil and gas formations.

OIL, GAS OR WATER RECORDS

CASING RECORD

FORMATION	CONTENT	FROM	TO	SIZE	PUT IN	PULLED OUT
				5-1/2"	4583'	

Describe in detail the manner in which the well was plugged, indicating where the mud fluid was placed and the method or methods used in introducing it into the hole. If cement or other plugs were used, state the character of same and depth placed, from _____ feet to _____ feet for each plug set.

Plugged back with crushed rock to 4525', dumped 5 sacks cement, top of cement @ 4490'. Filled hole with mud to 240', set rock bridge, dumped 20 sacks cement, top of cement @ 180'. Filled with mud to 35', set rock bridge and dumped 10 sacks cement for cap.

RECEIVED
STATE CORPORATION COMMISSION

(If additional description is necessary, use BACK of this sheet)
Name of Plugging Contractor Miller Casing Pulling Company
Address P. O. Box 711 Ex. Great Bend, Kansas

STATE OF KANSAS, COUNTY OF SEDGWICK, ss.
J. A. GILLILAND (employee of owner) or (owner) of the above-described well, being first duly sworn on oath, says: That I have knowledge of the facts, statements, and matters herein contained and the log of the above-described well as filed and that the same are true and correct. So help me God.

(Signature) J. A. Gilliland
1005 East Second Street, Wichita, Kansas
(Address)

SUBSCRIBED AND SWORN to before me this 7 day of July 19 54
Betty June Bayles
Notary Public.

My commission expires September 14, 1957

PLUGGING
FILE SEC 18 T 23 R 19W
BOOK PAGE 44 LINE 1

15. 047. 00095. 00. 01

Company: C. U. Bay
Contractor: Glenn R. Nyberg Drilling Company
Commenced: November 11, 1953
Completed: December 6, 1953

Farm: Lippoldt #1
Location: NW 1/4 NE Sec. 18-23S-19W
Edwards County, Kansas
Casing Record: 8 5/8" set at 239'
Dry and abandoned
Elevation: 2227 D.F.

cellar	5	
surface soil & clay	45	
sand	60	
sandy shale & gumbo	110	
sand	155	
gumbo clay	180	
sand	190	
clay & gumbo	215	
red bed	225	
shale	240	
blue shale	300	
shale & clay	335	
shale & clay & sand streaks	560	
shale, red bed & sand streaks	650	
red bed & shale	695	
anhydrite streak	705	
red bed	815	
sand	940	
red bed	1320	
red bed & shale	1360	
anhydrite	1382	
red bed & shale	1510	
shale & shells	1660	
shale & shells	1800	
shale & lime streaks	1875	
shale & lime streaks	2080	
shale & lime	2345	
lime & shale	2457	
lime & shale	2590	
lime & shale	2665	
lime & shale	2755	
lime & shale	2820	
lime & shale	2905	
lime & shale	3005	
lime & shale	3080	
shale & lime	3180	
shale & lime	3280	
shale & lime	3346	
shale & lime	3450	
shale & lime	3545	
shale & lime	3627	
lime & shale	3684	
lime, shale & sand streaks	3756	
lime & shale	3828	Top Heebner 3860' (-1628)
lime & shale	3884	Top Toronto 3882' (-1640)
lime & shale	3955	Brown Lime 3953' (-1721)
lime & shale	3991	Top Lansing 3965' (-1733)
lime	4039	
lime & shale	4093	
lime & shale	4130	
lime & shale	4184	
lime & shale	4251	
lime & shale	4300	
lime & shale	4339	
lime & shale	4395	
lime & shale	4445	
lime & shale	4477	
lime & shale	4531	
chert	4536	
chert	4546	
chert	4554	
chert	4566	
chert	4577	
chert	4594	
lime & shale	4637	
lime & shale & chert	4655	
cherty lime & shale	4688	
chert & lime	4702	
chert, lime & shale	4740	
cherty lime	4765	
cherty, lime & shale	4796	
cherty lime & red shale	4825	
cherty lime & shale	4860	

PLUGGING
 FILE SEC 18 T 23 R 19W
 BOOK PAGE 44 LINE 1

RECEIVED
 STATE COMMISSION
 JUL 2 1954
 CONSERVATION DIVISION
 Kansas

lime, shale & sand
simpson
shale & lime
arbuckle

4881
4900
4932
4975 T.D.

I hereby certify that this is a true and correct log of the above described well as shown by the drilling reports.

GLENN R. NYE DRILLING COMPANY

By Glenn R. Nye

STATE OF KANSAS)

ELLIS COUNTY)

ss

Subscribed to and sworn to before me, a notary public, in and for said County and State this 8th day of December, 1953.

John L. Spiss
Notary Public

My Commission Expires May 9, 1957