


WELL PLUGGING RECORD

Give All Information Completely  
Make Required Affidavit  
Mail or Deliver Report to:  
Conservation Division  
State Corporation Commission  
211 N. Broadway  
Wichita, Kansas

Rice County, Sec. 20 Twp. 21S Rge. 7W (E) (W)  
Location as "NE/CNW/SW" or footage from lines NW NW NW  
Lease Owner Tennessee Gas Transmission Company  
Lease Name Walter Manz Well No. 1  
Office Address Chase, Kansas  
Character of Well (completed as Oil, Gas or Dry Hole) Oil  
Date well completed June 13, 1956  
Application for plugging filed February 25, 1957  
Application for plugging approved February 26, 1957  
Plugging commenced March 30, 1957  
Plugging completed April 3, 1957  
Reason for abandonment of well or producing formation Failure to produce on commercial quantity.  
If a producing well is abandoned, date of last production March 1957  
Was permission obtained from the Conservation Division or its agents before plugging was commenced? Yes

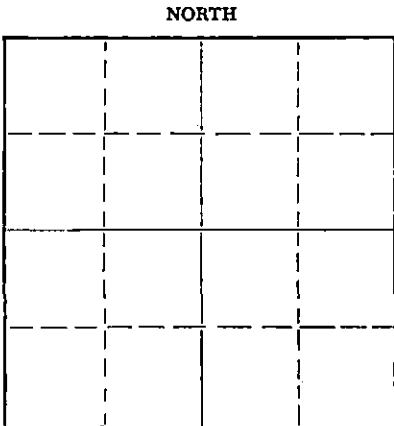

Locate well correctly on above Section Plat

Name of Conservation Agent who supervised plugging of this well Ruel Durkee  
Producing formation Mississippi Depth to top 3397 Bottom Total Depth of Well Feet  
Show depth and thickness of all water, oil and gas formations.

OIL, GAS OR WATER RECORDS

CASING RECORD

FORMATION	CONTENT	FROM	TO	SIZE	PUT IN	PULLED OUT
				8-5/8"	236'	None
				5-1/2"	3480'	3033'
				Plugged back to 3406' and perforated from 3396' to 3401'.		

Describe in detail the manner in which the well was plugged, indicating where the mud fluid was placed and the method or methods used in introducing it into the hole. If cement or other plugs were used, state the character of same and depth placed, from feet to feet for each plug set.

Filled the hole with sand from 3406' to 3387' and ran 6 sacks of cement. Mudded the hole to 225', set a 10' rock bridge and ran 15 sacks of cement. Mudded the hole to 20', set a 5' rock bridge and ran 5 sacks of cement on top. Plugging completed.

(If additional description is necessary, use BACK of this sheet)

Name of Plugging Contractor West Supply Co., Inc.  
Address Chase, Kansas

STATE OF Kansas, COUNTY OF Rice, ss.  
Glen E. Armour (employee of owner) or (owner/operator) of the above-described well, being first duly sworn on oath, says: That I have knowledge of the facts, statements, and matters herein contained and the log of the above-described well as filed and that the same are true and correct. So help me God.

(Signature) Glen E. Armour

(Address)

SUBSCRIBED AND SWORN TO before me this 9 day of April 19 57

Vincent O. Gray  
Notary Public.

My commission expires May 20, 1958

PLUGGING  
FILE SEC 20 T 21 R 7W  
BOOK PAGE 143 LINE 32

RECEIVED  
STATE CORPORATION COMMISSION

APR 11 1957 4-11-1957

WELL LOG ----- WALTER MANSZ #1  
Located, NW NW NW, Section 20-21S-7W,  
Rice County, Kansas

OWNER: TENNESSEE GAS TRANSMISSION  
ROTARY DRILLING CONTRACTORS: STERLING DRILLING COMPANY

COMMENCED: 5-7-56  
COMPLETED: 5-19-56

TOTAL DEPTH: 3480'

LOG

0-236 Sand & Shale  
236-500 Shale & Shells  
500-540 Shale  
540-585 Anhydrite  
585-1120 Shale & Shells  
1120-1255 Lime  
1255-1430 Shale & Lime  
1430-1515 Lime  
1515-2700 Shale & Lime  
2700-2765 Lime  
2765-2940 Lime & Shale  
2940-3180 Lime  
3180-3385 Shale & Lime  
3385-3400 Lime  
3400-3407 Chert  
3407-3453 Miss Lime  
3453-3480 Lime & Shale T D

CASING RECORD

Ran 236' 8-5/8" casing  
with 150 sacks cement and 3  
sacks chloride cement.

PRODUCTION RECORD

5 1/2" Set casing at 3480' with 100  
sacks cement.

PLUGGING  
FILE SEC 20 T 21 R 7 W  
BOOK PAGE 143 LI E 32

RECEIVED  
STATE CORPORATION COMMISSION

FEB 20 1957

CONSERVATION DIVISION  
Wichita, Kansas

RECEIVED  
APR 4 - 1957  
CONSERVATION DIVISION  
Wichita, Kansas