


STATE OF KANSAS
STATE CORPORATION COMMISSION

Form CP-4

Give All Information Completely
Make Required Affidavit
Mail or Deliver Report to
Conservation Division
State Corporation Commission
P. O. Box 17027

WELL PLUGGING RECORD

Wichita, Kansas 67217

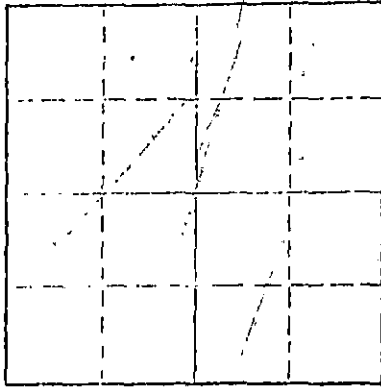

Locate well correctly on above
Section Plat

Rice County, Sec. 20 Twp. 21 Rge. 7 (E) (W)
Location as "NE/CNWSW" or footage from lines C NW SW
Lease Owner J & C Oil Company
Lease Name Burgert #1 Well No.
Office Address Box 16 176, Sterling, Kansas 67579
Character of Well (completed as Oil, Gas or Dry Hole)
Date well completed 19
Application for plugging filed 19
Application for plugging approved 19
Plugging commenced 10/2/74 19
Plugging completed 10/4/74 19
Reason for abandonment of well or producing formation depleted.

If a producing well is abandoned, date of last production 19
Was permission obtained from the Conservation Division or its agents before plugging was commenced? yes

Name of Conservation Agent who supervised plugging of this well Toman
Producing formation Depth to top Bottom Total Depth of Well 3428 Feet
Show depth and thickness of all water, oil and gas formations.

OIL, GAS OR WATER RECORDS

CASING RECORD

FORMATION	CONTENT	FROM	TO	SIZE	PUT IN	PULLED OUT
				8 5/8 5 1/2"	167 3426	none 2979'

RECEIVED
STATE CORPORATION COMMISSION
OCT 17 1974
CONSERVATION DIVISION
Wichita, Kansas

Describe in detail the manner in which the well was plugged, indicating where the mud fluid was placed and the method or methods used in introducing it into the hole. If cement or other plugs were used, state the character of same and depth placed, from feet to feet for each plug set.

Checked hole, ran sand to 3400' and ran 5 sacks cement. Loaded hole, shot pipe at 2990' and pulled 92 joints. Squeezed well with 3 sacks hulls, 2 sacks gel and 85 sacks cement.

PLUGGING COMPLETE.

Name of Plugging Contractor (If additional description is necessary, use BACK of this sheet)
KELSO CASING PULLING
Address CHASE, KANSAS

STATE OF KANSAS COUNTY OF RICE
R. DARRELL KELSO (employee of owner) or (owner or operator) of the above-described

well, being first duly sworn on oath, says: That I have knowledge of the facts, statements, and matters herein contained and the log of the above-described well as filed and that the same are true and correct. So help me God.

(Signature) R. Darrell Kelso
CHASE, KANSAS (Address)

Subscribed and Sworn to before me this 10th day of October, 1974

MARGARET MELCHER
NOTARY PUBLIC
Rice County, Kansas
My Commission Expires
Feb. 15, 1975

Margaret Melcher
Notary Public.

File

*20-21-7W
C NW SW*

APR 4 1970

STERLING DRILLING COMPANY
P. O. Box 129
Sterling, Kansas 67579

WELL LOG ----- Burgert #1

LOCATED: SW/4, Section 20-21S-7W, Rice County, Kansas

OWNER: C and J Oil Company
ROTARY DRILLING CONTRACTOR: Sterling Drilling Company

*20 BOPD + water
min*

COMMENCED: May 3, 1969
COMPLETED: May 9, 1969

TOTAL DEPTH: 3428'

LOG

CASING RECORD

0 - 90	Sand
90 - 175	Shale and Shells
175 - 455	Shale
455 - 1045	Shale and Shells
1045 - 1180	Lime and Shale
1180 - 1460	Shale
1460 - 2450	Shale and Lime
2450 - 3428	Lime

Ran 4 Joints, 161' 8 5/8" OD Casing.
Set pipe @ 167' K.B. with 175 sacks
HA5.. Plug down @ 5:45 PM, 5-3-69.

RECEIVED
STATE CORPORATION COMMISSION
OCT 11 1974
CONSERVATION DIVISION
Wichita, Kansas

3441 DDTD

Ran 107 joints 5 1/2" OD Casing - 14#
casing @ 3444.28'. Cemented @ 3426'
K.B. with 75 sacks salt saturated cement.
Plug down @ 2:30 PM, 5-9-69.