


STATE OF KANSAS
STATE CORPORATION COMMISSION

Form CP-4

WELL PLUGGING RECORD

Give All Information Completely
Make Required Affidavit
Mail or Deliver Report to:
Conservation Division
State Corporation Commission
212 No. Market
Wichita, Kansas

NORTH

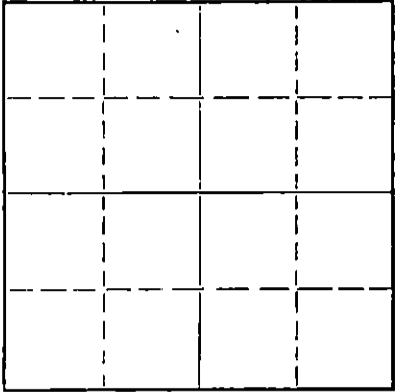

Locate well correctly on above
Section Plat

Hodgeman County. Sec. 12 Twp. 21S Rge. 23W ~~XX~~ (W)
Location as "NE/CNW/SW" or footage from lines Approx. C SW NE
Lease Owner TILCO
Lease Name Waterhouse Well No. 1
Office Address Box 486, Great Bend, Kansas
Character of Well (completed as Oil, Gas or Dry Hole) Dry Hole
Date well completed 4-25-68 19
Application for plugging filed 4-25-68 19
Application for plugging approved 4-25-68 19
Plugging commenced 4-25-68 19
Plugging completed 4-25-68 19
Reason for abandonment of well or producing formation Dry Hole

If a producing well is abandoned, date of last production _____ 19____
Was permission obtained from the Conservation Division or its agents before plugging was commenced? yes

Name of Conservation Agent who supervised plugging of this well Edgar Eaves
Producing formation _____ Depth to top _____ Bottom _____ Total Depth of Well 4520 Feet
Show depth and thickness of all water, oil and gas formations.

OIL, GAS OR WATER RECORDS

CASING RECORD

FORMATION	CONTENT	FROM	TO	SIZE	PUT IN	PULLED OUT
				8 5/8"	424	none

Describe in detail the manner in which the well was plugged, indicating where the mud fluid was placed and the method or methods used in introducing it into the hole. If cement or other plugs were used, state the character of same and depth placed, from _____ feet to _____ feet for each plug set.

Filled hole with heavy mud, spotted 100 sks. 50/50 Posmix, 6% gel @ 1150' through drill pipe
Spotted 30 sks. 50/50 Posmix through drill pipe @ 424'
Bridged @ 40' with plug 1/2 sk. hulls, 15 sks. 50/50 Posmix, 6% gel

RECEIVED
STATE CORPORATION COMMISSION
APR 30 1968
CONSERVATION DIVISION
Wichita, Kansas

(If additional description is necessary, use BACK of this sheet)

Name of Plugging Contractor Leben Drilling, Inc.
Address Box 486, Great Bend, Kansas 67530

STATE OF KANSAS, COUNTY OF BARTON, ss.
Leslie Kite (employee of owner) or (owner or operator) of the above-described

well, being first duly sworn on oath, says: That I have knowledge of the facts, statements, and matters herein contained and the log of the above-described well as filed and that the same are true and correct. So help me God.

(Signature) Leslie Kite
Box 486, Great Bend, Kansas 67530
(Address)

Subscribed and Sworn to before me this 29th day of April, 1968
Maude Owsen
Notary Public.

My commission expires April 1, 1971

DRILLER'S LOG

COMPANY: TILCO etal
 CONTRACTOR: LEBEN DRILLING, INC.
 FARM: WATERHOUSE #1
 LOCATION: APPROX. C SW NE
 SECTION 12-21S-23W
 HODGEMAN COUNTY, KANSAS
 COMMENCED: 4-16-68
 COMPLETED: 4-25-68

0	110	Sand, post rock
110	425	Sand, Shale
425	857	Shale
857	870	Blaine
870	950	Shale
950	1140	Sand
1140	1484	Shale, Redbed
1484	1516	Anhydrite
1516	1600	Shale
1600	2275	Shale, Lime Streaks
2275	2630	Lime, Shale
2630	2785	Lime
2785	2960	Lime, Shale Streaks
2960	3475	Shale, Lime
3475	3700	Lime, Shale
3700	3845	Shale, sand, lime
3845	3900	Shale, lime
3900	4403	Lime
4403	4460	Lime, shale
4460	4475	Chert
4475	4520	Lime, Chert
	<u>4520</u>	<u>RTD - D. & A.</u>

RECEIVED
 STATE CORPORATION COMMISSION
 APR 30 1968
 CONSERVATION DIVISION
 Wichita, Kansas

8 5/8" 20# new surface casing set @ 424' cemented with 250 sks.
 Common, 2% cc

I, Leslie Kite, do hereby certify that the above and foregoing is a true and correct copy of the log of the Waterhouse #1 Well, located Approximately C SW NE of Section 12, Township 21 South, Range 23 West, Hodgeman County, Kansas, as reflected by the records of Leben Drilling, Inc.

Leslie Kite

Leslie Kite

STATE OF KANSAS)
) SS
 COUNTY OF BARTON)

Subscribed and sworn to and before me, a Notary Public, in and for Barton County, Kansas, this 29th day of April, 1968.

Ulanda Nichols

Ulanda Nichols

My Commission Expires:
 April 1, 1971